State W	ell Report	······································		
	Filler's Log	For Office Use Only:		
Mississinni Donartmon	t of Environmental Quality	Aquifer:		
	nd Water Resources	Well #: M-26		
$ Driller b_{\alpha} \alpha \rangle N 0 0 1 1 1 1 1 1 1 1$	Box 10631	,		
	IS 39289-0631 961-5210	L. S. Elevation:		
	4-6938 (fax)	E-log #:		
	Ĺ			
State Law requires that this report be prepared by the lic				
Department at the above address within 30 days of comp Information on Well Owner		rehole Location		
(Landowner if borehole is not for a water well)				
Owner Name Brod Snith	Latitude: <u>34 ° 48 ' 11 '</u>	" Longitude: <u>8'} • 51</u> , <u>350</u> " 21 e): Conventional Survey,		
	Wethod of Lat/Long (circle on	e): Conventional Survey.		
Mailing Address: 4050 Jordon creek or				
	USGS quad, Hand-held			
1	NE 1/4 NW 1/4 Sec 28	Twn 35 Rng 6 W		
Hernondo MS 38632 City State Zip Code				
	Distance Direction	Nearest Town		
Telephone No. ((10) 832 - 0255				
Well / Bore				
Date drilling started: $\frac{3-19-08}{2}$ Date drilling completed: $\frac{3-19-08}{2}$	8 Hole depth: 200	Hole diameter: <u>63/4</u>		
Location of the source of any surface water used for drilling	A . 4			
Location of the source of any surface water used for drilling:	poment: A.A			
Logs run (circle all applicable) No log run Electric Gamma Ray Name of organization running log(s):	Density Sonic Neutron C	Other:		
	······································			
Purpose of borehole (check one): Water Well \checkmark Geotechnical/Geole	gical Investigation Ground	Source Heat Pump		
Seismic Survey Other (describe	NA			
If drilling is not related to water well construction		<u>ck</u>		
Purpose of Well (check one): Home \checkmark Industrial Public Supply	Irrigation Fish Culture	Other:		
If a flowing well, method of flow regulation: Valve O	her (describe)			
Static Water Level: 103 feet above of below (pircle one) I	and surface Date measured:	3-25-08		
Method of Measurement (circle one) steel tape electric tape air line other: <u>String (weight</u>				
Well depth: 200 Well grouted to a depth of 10 feet Type of grout (circle one): Neat Cement Bentonite Mix				
Casing length: 180 feet Casing diameter: 4 inches Type of casing: AUC				
Screen length: 25 feet Screen diameter: <u>4</u> inches Type of screen: <u>$\rho \prec c$</u>				
Screen slot size:				
Type of completion (circle all applicable): Gravel packed > Underreamed Telescoped Open hole Natural Development				
Other (describe):	μ.Α			
Top of lap pipe or reduction in casing: <u>A</u> feet. <u>If tel</u>	escoped or more than one scree	n, describe on next page		
		Form: OLWR-SWR-1A		
		RECEIVE		
		APR 2.5 2008		

*

BYOLWR

M. 26

The sketch below only required for water wells


If well	telescopes,	show	depths	on	sketch.

Ground Level-

Description of formations encountered must be provided for all wells and boreholes, unless specifically exempted by regulations

Description of Formations Encountered	From (depth)	To (depth)
clay dirt	Ground Level	15
led Sand	15	35
crovel	35	80
the clay	80	125
white soud.	175	300
		<u> </u>

If more than one screen, show location of each on sketch

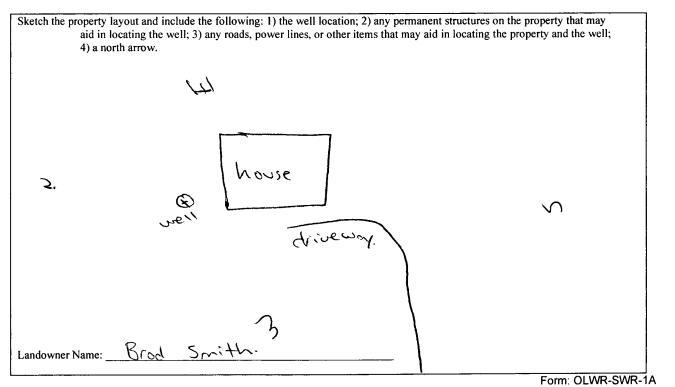

I certify that the well/borehole was drilled, constructed, and completed in accordance with all applicable requirements of the Mississippi Department of Environmental Quality and the Mississippi Department of Health regulations, if applicable, and state laws.

6-4-18-08 US. Moson 0-620 RECEIVED Date

Print Name of Responsible Licensee and License No.

Signature of Licensee

APR 2 5 2008

BY: OLWR

	STATE WELL REPORT	
County: Desoto	Part 2 Pump Installer's Completion Report	For Office Use Only:
Permit #:	Mississippi Department of Environmental Quality Office of Land and Water Resources	Aquifer:
Driller: Jares W. Mason	P.O. Box 10631	Well #: M-26
Date completed: 3-35-08	Jackson, MS 39289-0631 (601)961-5210 (601)354-6938 (fax)	Elevation:
Copy information from block on Part 1	(001)354-0938 (188)	

٢

This part of the report must be completed by a licensed water well contractor or a licensed pump installer. A copy of Part 1 of the report must be attached and both parts filed with the Department at the above address within 30 days of well completion.			
Well Owner Information	Well Location		
Owner Name: Brod Smith	Latitude: 34.48.111 Longitude: 89.51.350		
Mailing Address: 4050 Jordon creet de	Method of Lat/Long (check one): Conventional Survey,		
	USGS quad, Hand-held GPS_U, Survey-grade GPS		
Hervondo MS <u>38632</u> City State Zip Code	NE 1/2 NW 1/2 Sec 28 T35 R 6W		
	Distance Direction Nearest Town		
Telephone No. (99) 832-0255	<u>l'la Miles</u> w of Cockrum		

Pump Type Circle one		Power Type Circle one			
Air Lift	Jet	Submersible	Diesel Engine	Gasoline Engine	Natural Gas
Bucket	Piston	Turbine	Electric Motor	Hand	Tractor PTO
Centrifugal	Rotary	Flowing Well	Windmill	Other (specify):	
Other (specify):			Horse Power Ratin	g of Motor:	
Date Pump Installed:	3-25-0	<u>e</u>	Setting Depth:	140	feet
Rated Pump Capacit	y: <u>20</u>	Gallons Per Minute	Number of Stages:	13	

Pump Test Data	Method of Measuring Water Level	
Date Well Tested: 3-35-08 Static Water Level (A): 103 Feet Below Land Surface Pumping Water Level (B): 102 Feet Below Land Surface	Circle one Air Line Electric Measuring Line Steel Tape Other (specify): <u>String (weight</u>	
Drawdown [(B) - (A)]:Feet Below Land Surface	For flowing well, measured shut in head:feet	
Test Pumping Rate:Gallons Per Minute	Well yielded $\underline{\rightarrow}$ GPM with a drawdown of	
Duration of Pump Test (minimum 4 hours): <u></u> hours	feet after 24 hours of pumping	

I HEREBY CERTIFY that the above statements are true to the best of	f my knowledge.	
Jones w. Mason 0-620	Gans w. Mon	
Print Name of Pump Installer and License No. (if applicable)	Signature of Pump Installer	
		Form: OLIVIKESWHITH V CL

APR 2 5 2008 BY: OLW R