State Well Report			
	Driller's Log	For Office Use Only:	
Mississippi Departm	Minimipal Department of Environmental Quality		
	Office of Land and Water Resources P.O. Box 2309		
		L. S. Elevation:	
Date drilling completed	1)301- 3210	L. S. Elevation:	
(601)s	961- 5228 (fax)	E-log #:	
State Law requires that this report be prepared by the			
Department at the above address within 30 days of con			
Information on Well Owner (Landowner if borehole is not for a water well)		chole Location	
	Latitude: 34 . 46 . 405.	Longitude: 27.52, 603,	
Owner Name, Autonic Schwords	Latitude: $\frac{34}{24}$, 46 , 405 , Method of Lat/Long (circle one)	Conventional Survey	
Mailing Address: 64100 county line cel	USGS quad, Hand-held G	~	
Hervardo MI 38622	<u>500 1/4 SE 1/4 Sec 31</u>	Twn 7 Rng 600	
Hervando MS 38632 City State Zip Code	Distance Direction	Nearest Town	
Telephone No. 647 233 0694	<u>'14</u> Miles <u>w</u> of	Alphoba	
Well / Bo	rehole Data		
Date drilling started: $13-33-3$ Date drilling completed: $13-33$	<u>- こそ</u> Hole depth: <u>140</u> H	Hole diameter: 63/4	
Location of the source of any surface water used for drilling:	V4		
Method of dosing and volume of Chlorine used in drilling and dev	elopment: 10 million		
Logs run (circle all applicable). No log run Electric Gamma Ray Density Sonic Neutron Other:			
Purpose of borehole (check one): Water Well Geotechnical/Ge	ological Investigation Ground S	ource Heat Pump	
Seismic SurveyOther (descri If drilling is not related to water well construct		<u></u>	
Purpose of Well (check one): Home / Industrial Public Supply Irrigation Fish Culture Other:			
If a flowing well, method of flow regulation: Valve	Other (describe)		
Static Water Level: $\underline{80}$ feet above or below (gircle one) land surface Date measured: $\underline{12} - 2\underline{6} - 0\underline{3}$			
Method of Measurement (circle one) steel tape electric tape air line other: String (weight			
Well depth: <u>(40)</u> Well grouted to a depth of <u>(0)</u> feet Type of grout (circle one): Neat Cement Bentonite Mix			
Casing length: <u>130</u> feet Casing diameter: <u>4</u> inches Type of casing: <u>put</u>			
Screen length: 10 feet Screen diameter: 4 inches Type of screen: put			
Screen slot size: , 010 inches Setting depth: From 130 feet to 140 feet			
Type of completion (circle all applicable): Gravel packed Underreamed Telescoped Open hole Natural Development			
Other (describe):			
Top of lap pipe or reduction in casing: feet. If telescoped or more than one screen, describe on next page			
Form: OLWR-SWR-1A (04/08)			

JAN 2 3 2009 BY: OLWR

M-276

The sketch below only required for water wells


If well	telescopes,	show	depths o	n sketch.

Ground Level_

Description of formations encountered must be provided for all wells and boreholes, unless specifically exempted by regulations

<u>.</u>	Description of Formations Encountered	From (depth)	To (depth)
	clay dift	Ground Level	35
	led soud	32	40
	circuel	40	70
	white ilig	70 80	03
	white soud	<u> </u>	140
			<u>+</u>
			+
			+
			+
			<u> </u>
			+

If more than one screen, show location of each on sketch

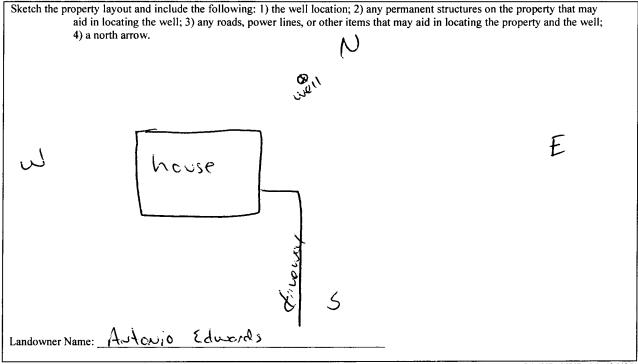

Form: OLWR-SWR-1A (04/08)

I certify that the well/borehole was drilled, constructed, and completed in accordance with all applicable requirements of the Mississippi Department of Environmental Quality and the Mississippi Department of Health regulations, if applicable, and state

1-31-09 laws. Jones W. Moson 0-630 1-1-1-19 Date

A W.N

Print Name of Responsible Licensee and License No.

Signature of Licensee

JAN 23 2009 BY: OLWR

RECEIVED

County: Deseto	Part 2	For Office Use Only:
	Pump Installer's Completion Report	For Gince Use Only:
Permit #:	Mississippi Department of Environmental Quality	Aquifer:
Driller: Jacs w. Mosco	Office of Land and Water Resources	
	P.O. Box 2309	Well #: <u>M-276</u>
ate completed: 13-33 - 08	Jackson, MS 39225	
	(601)961-5210	Dia atlant
Copy information from block on Part 1	(601)961-5228 (fax)	Elevation:

This part of the report must be completed by a licensed water well report must be attached and both parts filed with the Department a	
Well Owner Information	Well Location
Owner Name: Antonio Edwards	Latitude: 34.46.405 Longitude: 89.53.603
Mailing Address: 6400 County line it	Method of Lat/Long (check one): Conventional Survey, USGS quad , Hand-held GPS , Survey-grade GPS
Hernode MS 38633 City State Zip Code	$\frac{S \cup \sqrt{4} SE}{V_{14} SE} \frac{S \cup \sqrt{3}}{V_{14} SE} \frac{S \cup \sqrt{3}}{V_{14$
Telephone No. 662 233-0694	<u>ily</u> Miles <u>w</u> of <u>Alphoba</u>

	Pump Ty Circle on			Power Type Circle one	
Air Lift	Jet	Submersible	Diesel Engine	Gasoline Engine	Natural Gas
Bucket	Piston	Turbine	Electric Motor	Hand	Tractor PTO
Centrifugal	Rotary	Flowing Well	Windmill	Other (specify):	
Other (specify):			Horse Power Rating	of Motor: 3/4	
Date Pump Installed:	12-23-0	8	Setting Depth:	100	feet
Rated Pump Capacity	y: <u>10</u>	Gallons Per Minute	Number of Stages:	8	

Pump Test Data	Method of Measuring Water Level
Date Well Tested: 12-33-08	Circle one Air Line Electric Measuring Line Steel Tape
Static Water Level (A): <u>&</u> Feet Below Land Surface Pumping Water Level (B): <u>MA</u> Feet Below Land Surface	Other (specify): 5tring (weight
Drawdown [(B) – (A)]:Feet Below Land Surface	For flowing well, measured shut in head: $\underline{N}^{\mathcal{M}}$ feet
Test Pumping Rate: Gallons Per Minute	Well yielded \bigcirc GPM with a drawdown of 24
Duration of Pump Test (minimum 4 hours): <u> </u>	

I HEREBY CERTIFY that the above statements are true to the best of r	ny knowledge.
Gres w. Mean 0-620	Gos w. Man
Print Name of Pump Installer and License No. (if applicable)	Signature of Pump Installer
	Form: OLWR-SHECENED

JAN 2 3 2009 BY: OLWR