State Well Report			
	Driller's Log For Office Use Only:		
Mississippi Departme	nt of Environmental Quality Aquifer		
	Ind Water Resources Box 2309 Well #: M- 278		
	n, MS 39225 L. S. Elevation:		
	901-5210		
(601)96	1- 5228 (fax) E-log #:		
State Law requires that this report be prepared by the lic	ense holder responsible for the work and filed with the		
Department at the above address within 30 days of com			
Information on Well Owner (Landowner if borehole is not for a water well)	Well or Borehole Location		
	Latitude: 34 ° 46 'GIL " Longitude: 34° 48', 16kr		
Owner Name William Souge	Latitude: 34 • 46 • 611 " Longitude: 54• 48, 166, 37 IO Method of Lat/Long (circle one): Conventional Survey,		
Mailing Address: 5720 Emily LYNNe Love.			
WINDON FRAME STA	USGS quad, Hand-held GPS, Survey-grade GPS		
<u>Hermondo My 38632</u> City State Zip Code	NE 1/2 SW 1/2 Sec 35 Twn 35 Rng 6W		
Hernando MS 38632	Distance Direction Nearest Town		
	112 Miles <u>SE</u> of <u>Cocktum</u>		
Telephone No. (101) 461-5489			
Well / Bore	chole Data		
Date drilling started: $\frac{\partial - 6 - c \gamma}{\partial - 6}$ Date drilling completed: $\frac{\partial - 6 - c \gamma}{\partial - 6}$	Hole depth: <u>40</u> Hole diameter: <u>674</u>		
Location of the source of any surface water used for drilling:	rA		
Location of the source of any surface water used for drilling:	lopment:		
Logs run (circle all applicable). No log run Electric Gamma Ray	Density Sonic Neutron Other:		
Logs run (circle all applicable). No log run Electric Gamma Ray Name of organization running log(s):			
Purpose of borehole (check one): Water Well Geotechnical/Geo	logical Investigation Ground Source Heat Pump		
Seismic SurveyOther (describe			
Purpose of Well (check one): Home <u>Industrial</u> Public Suppl	y Irrigation Fish Culture Other:		
If a flowing well, method of flow regulation: Valve (Other (describe)		
Static Water Level:feet above or below (circle one)			
Method of Measurement (circle one) steel tape electric tape air line other: Strig I regist			
Well depth: 140 Well grouted to a depth of 10 feet Type of grout (circle one): Neat Cement Bentonite Mix			
Casing length: 120 feet Casing diameter: 4 inches Type of casing: pdc			
Screen length: <u> </u>			
Screen slot size: <u>CID</u> inches Setting depth: From_			
Type of completion (circle all applicable): Gravel packet Underreamed Telescoped Open hole Natural Development			
Other (describe):			
Top of lap pipe or reduction in casing: feet. If telescoped or more than one screen, describe on next page			
Form: OLWR-SWR-1A (04/08)			

.

۴.

. .

RECEIVED MAR 0 5 2009 BY: OLWR

M-278


The sketch below only required for water wells

If well telescopes, show depths on sketch.		
Ground Level	Desc	

Description of formations encountered must be provided for all wells and boreholes, unless specifically exempted by regulations

From (depth)	To (depth)
Ground Level	5
5	US .
15	35
35	60
60	90
90	105
(05	381
38	140
	Ground Level 5 15 35 60 90 (65

If more than one screen, show location of each on sketch

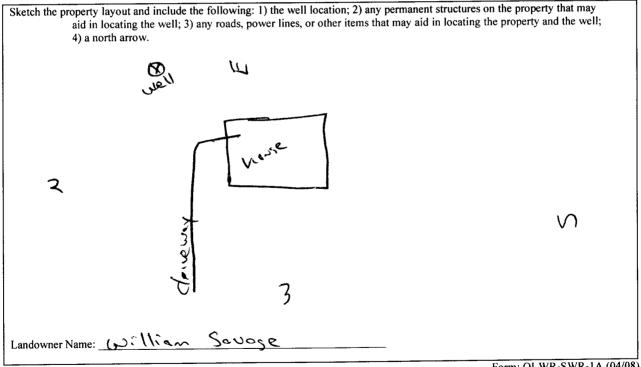

Form: OLWR-SWR-1A (04/08)

I certify that the well/borehole was drilled, constructed, and completed in accordance with all applicable requirements of the Mississippi Department of Environmental Quality and the Mississippi Department of Health regulations, if applicable, and state

laws. Jones W-Mason U-620 for w. Mana Signature of Licensee 90-E-E Print Name of Responsible Licensee and License No. Date

MAR 0 5 2009 **BY: OLWR**

RECEIVED

STATE WELL REPORT				
County: Desito	Part 2 Pump Installer's Completion Report	For Office Use Only:		
Permit #:	Mississippi Department of Environmental Quality	Aquifer:		
Driller: Janes w. Masan	Office of Land and Water Resources P.O. Box 2309	Well #: M-278		
Date completed: <u>$\partial\gamma$-0γ</u>	Jackson, MS 39225 (601)961-5210	Elevation:		
Copy information from block on Part 1	(601)961-5228 (fax)			
This part of the perperturbation was be completed by a licensed water well contractor or a licensed nump installer. A conv of Part 1 of the				

report must be attached and both parts filed with the Department at the above address within 30 days of well completion.	
Well Owner Information	Well Location
Owner Name: William Souge	Latitude: 34.46.611 Longitude: 81.48-166
Mailing Address: 5720 Emily Lynn Love	Method of Lat/Long (check one): Conventional Survey,
Honey ridge subdivision	USGS quad, Hand-held GPS, Survey-grade GPS
Hernando MJ 38632	NE 1/ Sw 1/4 Sec 35 T 35 R 6 W

Distance

Direction

112 Miles SE of certerum

Nearest Town

IntervandoMI36637CityStateZip Code

Telephone No. (901) 461-5489

. .

	Pump Typ Circle one			Power Type Circle one	
Air Lift	Jet	Submersible	Diesel Engine	Gasoline Engine	Natural Gas
Bucket	Piston	Turbine	Electric Motor	Hand	Tractor PTO
Centrifugal	Rotary	Flowing Well	Windmill	Other (specify):	
Other (specify):		Horse Power Rating	g of Motor: 14	.=	
Date Pump Installed	1: <u>3-7-0</u> °	<u>}</u>	Setting Depth:	130	feet
Rated Pump Capacit	ty: (U	Gallons Per Minute	Number of Stages:	රි	

Pump Test Data	Method of Measuring Water Level Circle one	
Date Well Tested: <u>$\partial - \gamma - \delta \hat{\gamma}$</u> Static Water Level (A): <u>110</u> Feet Below Land Surface Pumping Water Level (B): <u>$\mathcal{N}\Lambda$</u> Feet Below Land Surface	Air Line Electric Measuring Line Steel Tape Other (specify): <u>String (Leip L</u>	
Drawdown $[(B) - (A)]$: Feet Below Land Surface	For flowing well, measured shut in head:feet	
Test Pumping Rate: Gallons Per Minute Duration of Pump Test (minimum 4 hours): _ う Ҷ hours	Well yielded GPM with a drawdown of feet after hours of pumping	

I HEREBY CERTIFY that the above statements are true to the best of <u>Jaces where</u> O-620 Print Name of Pump Installer and License No. (if applicable)	of my knowledge. Signature of Pump Installer Form: OLWR-SWR-1B (04/08) RECEIVED
	MAR 0 5 2009

BY: OLWR