	State Wo	ell Report	For Office Use Only	
County: Deseto	Part 1 – Driller's Log		For Office Use Only:	
Permit #:	Mississippi Department of Environmental Quality Office of Land and Water Resources		Aquifer:	
	P.O. Box 2309		Well #:	
Driller: Janes W. Meson		MS 39225 61- 5210	L. S. Elevation:	
Date drilling completed: 1-12-12	, ,	- 5228 (fax)	E-log#:	
State Law requires that this report t	he nrenared by the lices	 nse holder responsible for t		
Department at the above address w				
Information on Well Ow	ner	Well or		
(Landowner if borehole is not for	a water well)	Latitude: 34 . 46 , 683	" Longitude: <u>89 ° 50 , 586,</u>	
Owner Name Track Ross		Method of Lat/Long (circle on	e): Conventional Survey.	
Mailing Address: 5685 Castle 100	ck creekdr.			
LOT 5			GPS, Survey-grade GPS	
hernendo Ms City State	38632	NE 1/200 1/2 Sec 33	Twn 3s Rng 6w	
City State	Zip Code	Distance Direction		
Telephone No. (901) 508 - 6207	<u>, </u>	J' Miles NE	HIDWOOG	
	Wall / Danah	ala Data		
	Well / Boreh		6.21.	
Date drilling started: [-12-12 Date drilli	ng completed: (-()-(Hole depth:	Hole diameter: 6314	
Location of the source of any surface water u Method of dosing and volume of Chlorine u	used for drilling: <u>\(\mu\) A</u> sed in drilling and develo	pment: NA		
Logs run (circle all applicable). No log run Name of organization running log(s):	Electric Gamma Ray	Density Sonic Neutron	Other:	
Purpose of borehole (check one): Water Well	Geotechnical/Geolog	gical Investigation Ground	Source Heat Pump	
Seismic Sur If drilling is not related to	rveyOther (describe) water well construction	skip the remainder of this blo	ck	
Purpose of Well (check one): Home Industrial Public Supply Irrigation Fish Culture Other:				
If a flowing well, method of flow regulation: Valve Other (describe)				
Static Water Level: 40 feet above or below circle one) land surface Date measured: 1-14-12				
Method of Measurement (circle one) steel tape electric tape air line other: String (weight				
Well depth: 95 Well grouted to a depth of 0 feet Type of grout (circle one): Neat Cement Bentonite Mix				
Casing length: 65 feet Casing	diameter:	inches Type of casing:	puc	
Screen length: 10 feet Screen			•	
Screen slot size:, OTOinches	Setting depth: From	85 feet to 95	feet	
Type of completion (circle all applicable): Gravel packed Underreamed Telescoped Open hole Natural Development				
	•	А	i	
Top of lap pipe or reduction in casing:	M4 feet. If teles	scoped or more than one scree	n, describe on next page	

Form: OLWR-SWR-1A (04/08)

RECEIVED

FEB 1 6 2012

BY: OLWR

The sketch	below on	lv required	l for	water	wells


If well telescopes, show depths on sketch.

Ground Level.

Description of formations encountered must be provided for all wells and boreholes, unless specifically exempted by regulations

Description of Formations Encountered	From (depth)	To (depth)
clay dirt	Ground Level	15
red soud	15	25
ied sad grael	3 <i>E</i>	38
white soud	38	95
		1
	1	1
	 	
	 	
	<u> </u>	

If more than one screen, show location of each on sketch

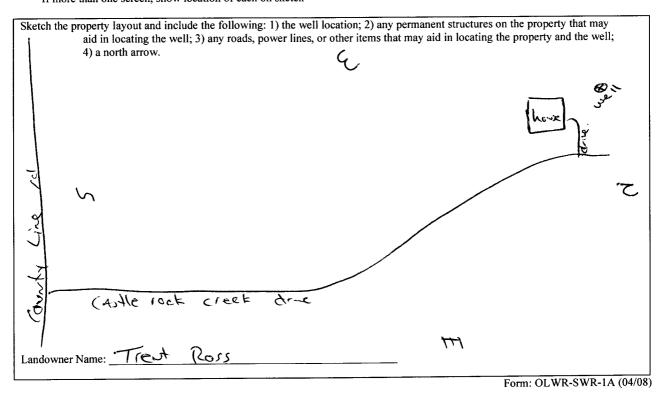

I certify that the well/borehole was drilled, constructed, and completed in accordance with all applicable requirements of the Mississippi Department of Environmental Quality and the Mississippi Department of Health regulations, if applicable, and state

laws.	_	\sim	
Janes W. Moson 0-620	3-2-15	Jous W. Man	RECEIVED
Print Name of Responsible Licensee and License No.	Date	Signature of Licensee	

FEB 1 6 2012

BY: OLWR

Part 2 Pump Installer's Completion Report Mississippi Department of Environmental Quality Office of Land and Water Resources P.O. Box 2309 Jackson, NS 30225 (601)961-5210 (601)		STATE WE	ELL REPORT	
Diller School Sc	,	Part 2 Pump Installer's Completion Report Mississippi Department of Environmental Quality Office of Land and Water Resources P.O. Box 2309		·
Copy information from black on Part (601)961-5218 (fixx) Elevation				
Well Owner Information Well Owner Informat		(601)	961-5210	
Owner Name: Teach Ross Mailing Address: 5685 content (sect arget 20 or Method of Lat/Long (check one): Conventional Survey. LOT 5 LOT 5 Method of Lat/Long (check one): Conventional Survey. USGS quad. Hand-held GPS. Survey-grade GPS. Distance Direction Nearest Town Nearest Town Direction Nearest Town Direction Nearest Town Direction Nearest Town Direction Nearest Town Nearest Town Direction Properties Neare	This part of the report must be completed report must be attached and both parts fi	by a licensed water well o led with the Department a	contractor or a licensed pun t the above address within 3	np installer. A copy of Part 1 of the 0 days of well completion.
Mailing Address: 5687 cothe (ock creek & well and burlance) Coty State Zip Code	Well Owner Informa	tion	,	Well Location
USGS quad, Hand-held GPS, Survey-grade GPS	*		<u></u>	
Distance Direction Nearest Town		e rock creek drug	i	
Telephone No. 90 508 620 Distance Direction Nearest Town Pump Type Circle one Power Type Circle one		254.25		
Pump Type Circle one Circ	City State	Zip Code		
Circle one Air Lift Jet Submersible Bucket Piston Turbine Centrifugal Rotary Flowing Well Other (specify): Date Pump Installed: 1 - 14 - 12 Setting Depth: Setti	Telephone No. (90) 508 - 6207			
Circle one Air Lift Jet Submersible Bucket Piston Turbine Centrifugal Rotary Flowing Well Other (specify): Date Pump Installed: 1 - 14 - 12 Setting Depth: Setti				
Bucket Piston Turbine Centrifugal Rotary Flowing Well Windmill Other (specify):				
Centrifugal Rotary Flowing Well Windmill Other (specify):	Air Lift Jet	Submersible	Diesel Engine Gas	soline Engine Natural Gas
Other (specify):	Bucket Piston	Turbine	Electric Motor Ha	nd Tractor PTO
Setting Depth:	-	Flowing Well		· ·
Pump Test Data Method of Measuring Water Level Circle one	•			
Circle one Date Well Tested:				j
Date Well Tested:	Pump Test Data		Method of	
Static Water Level (A):	Date Well Tested: 1-14-12		Air Line Flectric	
Drawdown [(B) - (A)]:	Static Water Level (A): 40 Feet Below Land Surface			
Test Pumping Rate:Gallons Per Minute	Pumping Water Level (B): Feet		For flowing well massure	d shut in head: feet
Duration of Pump Test (minimum 4 hours):			_	
Tones w. Mosque 0-620 Print Name of Pump Installer and License No. (if applicable) Senature of Pump Installer RECEIVE				
Tones w. Meson 0-620 Print Name of Pump Installer and License No. (if applicable) Segnature of Pump Installer RECEIVE		and the de-	f my knowledge	
Print Name of Pump Installer and License No. (if applicable) Segnature of Pump Installer RECEIVE				1 -
Form: OLWR-SWR-1B (04/08)	Print Name of Pump Installer and License	No. (if applicable)	Sagnature of Pum	p Installer PECEIVE

FEB 1 6 2012

BY: OLWR