

State Well Report

Part 1 - Driller's Log

Mississippi Department of Environmental Quality
Office of Land and Water Resources
P.O. Box 2309
Jackson, MS 39225
(601)961-5210
(601)961-5228 (fax)

County: Desoto
Permit #: _____
Driller: Jones W. Mason
Date drilling completed: 3-4-13

For Office Use Only:
Aquifer: M318
Well #: _____
L. S. Elevation: _____
E-log #: _____

State Law requires that this report be prepared by the license holder responsible for the work and filed with the Department at the above address within 30 days of completion of drilling of the well or borehole.

Information on Well Owner (Landowner if borehole is not for a water well)	Well or Borehole Location
Owner Name <u>Timber Ridge Homes</u>	Latitude: <u>34.479583</u> Longitude: <u>87.473845</u>
Mailing Address: <u>Lot 1 Mosby Lane</u>	Method of Lat/Long (circle one): Conventional Survey, <u>06</u>
<u>Hernando</u> <u>MS</u> <u>38632</u>	USGS quad: <u>Hand-held GPS</u> Survey-grade GPS <u>/</u>
City State Zip Code	<u>NW 1/4 NW 1/4</u> Sec <u>36</u> Twn <u>35</u> Rng <u>6W</u>
Telephone No. <u>(901) 299-9280</u>	Distance <u>1.4</u> Miles Direction <u>SE</u> of Nearest Town <u>COCKRUM</u>

Well / Borehole Data

Date drilling started: 3-4-13 Date drilling completed: 3-4-13 Hole depth: 160 Hole diameter: 6.314

Location of the source of any surface water used for drilling: N/A

Method of dosing and volume of Chlorine used in drilling and development: N/A

Logs run (circle all applicable): No log run Electric Gamma Ray Density Sonic Neutron Other: _____

Name of organization running log(s): N/A

Purpose of borehole (check one): Water Well Geotechnical/Geological Investigation _____ Ground Source Heat Pump _____

Seismic Survey _____ Other (describe) N/A

If drilling is not related to water well construction, skip the remainder of this block

Purpose of Well (check one): Home Industrial _____ Public Supply _____ Irrigation _____ Fish Culture _____ Other: _____

If a flowing well, method of flow regulation: Valve N/A Other (describe) _____

Static Water Level: 90 feet above or below (circle one) land surface Date measured: 3-5-13

Method of Measurement (circle one) steel tape electric tape air line other: string weight

Well depth: 160 Well grouted to a depth of 10 feet Type of grout (circle one): Neat Cement Bentonite Mix

Casing length: 150 feet Casing diameter: 4 inches Type of casing: pvc

Screen length: 10 feet Screen diameter: 4 inches Type of screen: pvc

Screen slot size: .010 inches Setting depth: From 150 feet to 160 feet

Type of completion (circle all applicable): Gravel packed Underreamed Telescoped Open hole Natural Development

Other (describe): N/A

Top of lap pipe or reduction in casing: N/A feet. **If telescoped or more than one screen, describe on next page**

Form: OLWR-SWR-1 (4/08)


APR 03 2013

BY: OLWR

The sketch below only required for water wells

Description of formations encountered must be provided for all wells and boreholes, unless specifically exempted by regulations

If well telescopes, show depths on sketch.

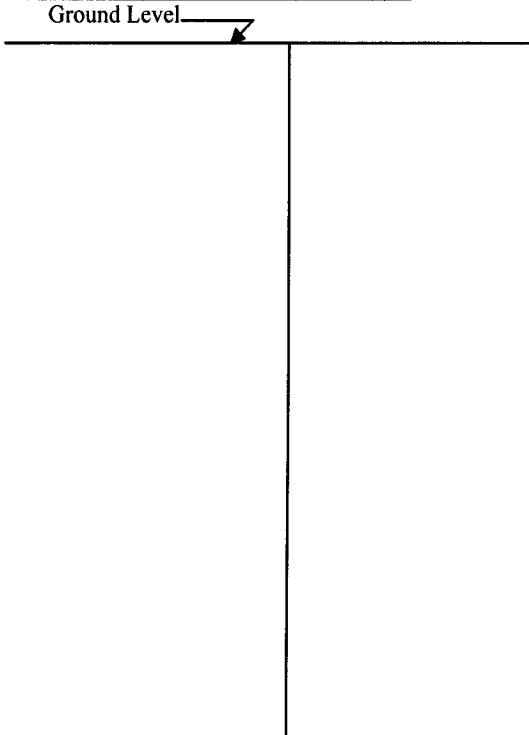

Description of Formations Encountered	From (depth)	To (depth)
red sand	Ground Level	5
white sand	5	20
white clay	20	50
Blue clay	50	90
white sand	90	160

If more than one screen, show location of each on sketch

Sketch the property layout and include the following: 1) the well location; 2) any permanent structures on the property that may aid in locating the well; 3) any roads, power lines, or other items that may aid in locating the property and the well; 4) a north arrow.

Landowner Name: Timber Ridge Homes

Form: OLWR-SWR-1A (04/08)

I certify that the well/borehole was drilled, constructed, and completed in accordance with all applicable requirements of the Mississippi Department of Environmental Quality and the Mississippi Department of Health regulations, if applicable, and state laws.

Joe W. Mason 0-620 4-1-13
Print Name of Responsible Licensee and License No. Date

Joe W. Mason
Signature of Licensee

RECEIVED
APR 03 2013
BY: OLWR

STATE WELL REPORT

Part 2

Pump Installer's Completion Report
 Mississippi Department of Environmental Quality
 Office of Land and Water Resources
 P.O. Box 2309
 Jackson, MS 39225
 (601)961-5210
 (601)961-5228 (fax)

For Office Use Only:

Aquifer: _____

Well #: M318

Elevation: _____

County: DeSoto
 Permit #: _____
 Driller: Jones W. Masen
 Date completed: 3-5-13
Copy information from block on Part 1

This part of the report must be completed by a licensed water well contractor or a licensed pump installer. A copy of Part 1 of the report must be attached and both parts filed with the Department at the above address within 30 days of well completion.

Well Owner Information	Well Location
Owner Name: <u>Timber Ridge Homes</u>	Latitude: <u>34.47.05.83</u> Longitude: <u>89.47.38.45</u>
Mailing Address: <u>LOT 1 Mosby Lane</u>	Method of Lat/Long (check one): Conventional Survey _____
<u>Herndon MS 38632</u>	USGS quad _____, Hand-held GPS <input checked="" type="checkbox"/> Survey-grade GPS _____
City State Zip Code	<u>NW 1/4 NW 1/4 Sec 36 T 3s R 6w</u>
Telephone No. <u>(601) 299-9280</u>	Distance Direction Nearest Town
	<u>1.4 Miles SE of Coakrum</u>

Pump Type Circle one	Power Type Circle one
Air Lift Jet <input type="checkbox"/> Submersible <input checked="" type="checkbox"/> Turbine <input type="checkbox"/>	Diesel Engine Gasoline Engine Natural Gas
Bucket Piston Turbine	Electric Motor <input checked="" type="checkbox"/> Hand Tractor PTO
Centrifugal Rotary Flowing Well	Windmill Other (specify): _____
Other (specify): _____	Horse Power Rating of Motor: <u>3/4</u>
Date Pump Installed: <u>3-5-13</u>	Setting Depth: <u>120</u> feet
Rated Pump Capacity: <u>10</u> Gallons Per Minute	Number of Stages: <u>8</u>

Pump Test Data	Method of Measuring Water Level Circle one
Date Well Tested: <u>3-5-13</u>	Air Line Electric Measuring Line Steel Tape
Static Water Level (A): <u>90</u> Feet Below Land Surface	Other (specify): <u>string weight</u>
Pumping Water Level (B): <u>NA</u> Feet Below Land Surface	For flowing well, measured shut in head: <u>NA</u> feet
Drawdown [(B) - (A)]: <u>NA</u> Feet Below Land Surface	Well yielded <u>10</u> GPM with a drawdown of
Test Pumping Rate: <u>10</u> Gallons Per Minute	<u>NA</u> feet after <u>24</u> hours of pumping
Duration of Pump Test (minimum 4 hours): <u>24</u> hours	

I HEREBY CERTIFY that the above statements are true to the best of my knowledge.

Jones W. Masen 0-620 Jones W. Masen
 Print Name of Pump Installer and License No. (if applicable) Signature of Pump Installer

RECEIVED

APR 03 2013