	State W	ell Report	
County: Drsoto		Oriller's Log	For Office Use Only:
	Mississippi Department of Environmental Quality		Aquifer:
Permit #:	Office of Land and Water Resources P.O. Box 2309		Well#: <u>M319</u>
Driller: James W. Mosum		ı, MS 39225 961- 5210	L. S. Elevation:
Date drilling completed: 3-22-13		1- 5228 (fax)	E-log #:
State Law requires that this repo] rt be prepared by the lice	ense holder responsible for t	
Department at the above address	s within 30 days of comp	letion of drilling of the well	or borehole.
Information on Well ((Landowner if borehole is not f			orehole Location
Owner Name Jack Joslin	·	Latitude: $34 \circ 47 \cdot 48.7$	"Longitude: 89 ° 51 ,10.91,
		Method of Lat/Long (circle or	ne): Conventional Survey,
Mailing Address: 4408 Jar	don creek Dr.		GPS Survey-grade GPS
107 12			V Twn 35 Rng 6 ₩
Hernonto M	s 38632	I SW NE	
City Sta	te Zip Code	Distance Direction	Nearest Town of Alphaba
Telephone No. (901) 337-5600)		· // // // // // // // // // // // // //
	Well / Bore	hole Data	
Date drilling started: 3-33-13 Date dr	rilling completed: <u>3-33-</u>	13 Hole depth: 315	Hole diameter: 63/4
Location of the source of any surface wat	er used for drilling:	14	
Location of the source of any surface wat Method of dosing and volume of Chlorin	e used in drilling and devel	opment: NIA	
Logs run (circle all applicable). No log run Name of organization running log(s):	Electric Gamma Ray	Density Sonic Neutron	Other:
Purpose of borehole (check one): Water W	/ell Geotechnical/Geolo	ogical Investigation Ground	I Source Heat Pump
Seismic If drilling is not related	Survey Other (describe to water well construction)(/\- n, skip the remainder of this bl	ock
Purpose of Well (check one): Home $\underline{\checkmark}$ l	Industrial Public Supply	Irrigation Fish Culture	Other:
If a flowing well, method of flow regulation	on: Valve <u>~ (A</u> O	ther (describe)	
Static Water Level:	bove of below (sircle one) l	and surface Date measured:	3-22-13
Method of Measurement (circle one) steel tape electric tape air line other: 51129 weight			
Well depth: 215 Well grouted to a depth of 10 feet Type of grout (circle one): Neat Cement Bentonite Mix			
Casing length: 195 feet Casing diameter:inches Type of casing:			
Screen length: 30 feet Screen diameter: inches Type of screen: pvc			
Screen slot size: , 010 inches	Setting depth: From	195 feet to <u></u>	feet
Type of completion (circle all applicable): Gravel packed Underreamed Telescoped Open hole Natural Development			
Other (describe):			
Top of lap pipe or reduction in casing: feet. If telescoped or more than one screen, describe on next page			
			Form: OLWR-SWR-TA (04708)

APR 1 8 2013




Description of formations encountered must be provided for all wells and boreholes, unless specifically exempted by regulations

If well telescopes, show depths on sketch.		
Ground Level		
"		

Description of Formations Encountered	From (depth)	To (depth)
clay dirt	Ground Level	15
1cd Soud	15	40
gravel	40	70
Blue clay	70	180
white said	180	au
		1
		
		1
		
		

If more than one screen, show location of each on sketch

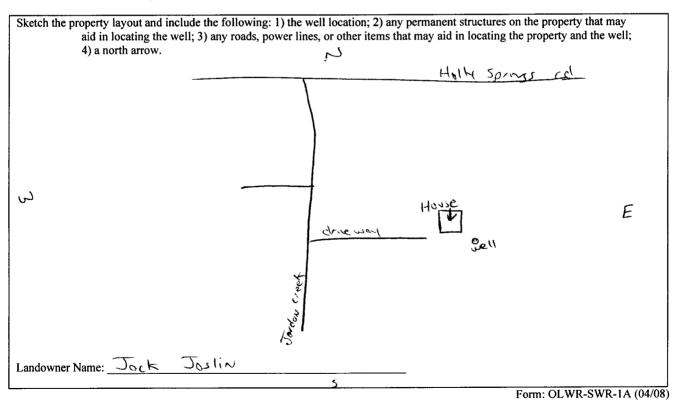

I certify that the well/borehole was drilled, constructed, and completed in accordance with all applicable requirements of the Mississippi Department of Environmental Quality and the Mississippi Department of Health regulations, if applicable and state

Jones	w. Moson	0-620
Drint Name of	· Dasnansihla I icansas	and License No

Date

Signature of Licensee

STATE WELL REPORT Part 2

County: Desoto Driller: Jones W. Moson

Permit #: ____

Date completed: 3-33-13

Pump Installer's Completion Report
Mississippi Department of Environmental Quality
Office of Land and Water Resources
P.O. Box 2309 Jackson, MS 39225 (601)961-5210

For Office Use Only:		
Aquifer:		
Well #:	M319	

Copy information from block on Part 1	(601)961-5228 (fax)	Elevation:
	by a licensed water well contractor or a licensed pump is ed with the Department at the above address within 30 do	

Well Owner Information	Well Location	
Owner Name: Jock Joslin	Latitude: 34.47.48.41 Longitude: 89.51.10.91	
Mailing Address: 4408 Jordan crook dr.	Method of Lat/Long (check one): Conventional Survey,	
	USGS quad, Hand-held GPS, Survey-grade GPS	
Hernendo Ms 38632 City State Zip Code	NW 1/ SE 1/4 Sec 39 T 35 R 6W	
Chy State Zip Code	Distance Direction Nearest Town	
Telephone No. (901) 337 - 5600	1'12 Miles NE of Alphoba	

Pump Type Circle one		Power Type Circle one			
Air Lift	Jet	Submersible	Diesel Engine	Gasoline Engine	Natural Gas
Bucket	Piston	Turbine	Electric Motor	Hand	Tractor PTO
Centrifugal	Rotary	Flowing Well	Windmill	Other (specify):	
Other (specify):			Horse Power Rating	g of Motor: 3/4	
Date Pump Installed: _	3-22-13		Setting Depth:	100	feet
Rated Pump Capacity:	10	Gallons Per Minute	Number of Stages:	8	

Pump Test Data	Method of Measuring Water Level	
Date Well Tested: 3-32-13	Circle one	
Static Water Level (A): Feet Below Land Surface	Air Line Electric Measuring Line Steel Tape	
Pumping Water Level (B):Feet Below Land Surface	Other (specify): string / weight	
Drawdown [(B) – (A)]: Feet Below Land Surface	For flowing well, measured shut in head:feet	
Test Pumping Rate:Gallons Per Minute	Well yieldedf OGPM with a drawdown of	
Duration of Pump Test (minimum 4 hours):hours	feet after <u>∂</u> hours of pumping	

Tones w. Morry 0-620 Cross w. May APR 1 8 2013	I HEREBY CERTIFY that the above statements are true to the best o	of my knowledge.	RECEIVE
	Javes w. Moson 0-620	Gras w. Men	APR 1 8 2013
Print Name of Pump Installer and License No. (if applicable) Signature of Pump Installer Form: OLVAR STAR 4B (04/08)			

Form: OLWR-STAR WAVE WAVE