

State Well Report

Part 1

Mississippi Department of Environmental Quality

Office of Land and Water Resources

P.O. Box 2309
Jackson, MS 39225

For Office Use Only
Aquifer: _____
Well #: <u>M1321</u>
L.S. Elevation: _____
E-Long #: _____

County: <u>DE SOTO</u>
Permit #: _____
Driller: <u>BOB SMITH</u>
Date drilling complet: <u>4-16-13</u>

State Law requires that this report be prepared by the driller in detail and filed with the Department within 30 days of completion of drilling of the well.

Well Owner Information	Well Location
Owner Name: <u>CITRUS ELDON</u>	Latitude: <u>34° 46' 59"</u> Longitude: <u>89° 49' 19"</u>
Mailing Address: <u>5205 TREAMAY RD</u> <u>Hennepin, MS 38632</u>	Method of Lat/Long (circle one): Conventional Survey, USGS quad, Hand-held GPS, Survey-grade GPS
City: _____ State: _____ Zip Code: _____	<u>SE 1/4 NW 1/4 Sec 34 Twn T35 Rng R6W</u>
Telephone No. <u>337 277-3656</u>	Distance: <u>1 Miles</u> Direction: <u>S/W</u> of <u>CORNUM</u>

Well Data

Purpose of Well (circle one) Home Industrial Public Supply Irrigation Fish Culture Other _____

Date well drilling started: 4-16-13 Date well drilling completed: 4-16-13

If flowing, method of flow regulation: Valve _____ Other (describe) _____

Static Water Level: 85 feet above or below (circle one) land surface Date measured: 4-17-13

Method of Measurement (circle one) steel tape electric tape air line other: LINE + WEIGHT

Hole Depth: 155 Well depth: 155 Well grouted to a depth of 10 feet

Type of grout: (circle one) Cement Bentonite Mix

Casing length: 145 feet Casing diameter: 4 inches Type of casing: PVC

Screen length: 10 feet Screen diameter: 4 inches Type of screen: PVC

Screen slot size: 13 MDS inches Setting depth: From 145 feet to 155 feet

Type of completion (circle all applicable):
 Gravel packed Underreamed Telescoped Open hole Natural Development
 Other (describe): _____

Top of lap pipe or reduction casing: _____ feet. If telescoped or more than one screen, describe on back

Logs run (circle one): No log run Electric Gamma Ray Density Sonic Neutron Other: _____

Name of organization running log(s): _____

I certify that the well drilled, constructed, and completed in accordance with all applicable requirements of the Mississippi Department of Environmental Quality and/or the Mississippi Department of Health regulations and state laws.

BOB SMITH 0-645 [Signature]

Print name of Water Contractor and License No. Signature of Water Well Contractor

RECEIVED
MAY 14 2013
BY: OLWR

State Well Report

Part 2

Pump Installer's Completion Report
 Mississippi Department of Environmental Quality
 Office of Land and Water Resources
 P.O. Box 2309
 Jackson, MS 39225

For Office Use Only

Aquifer: _____
 Well #: M321
 Elevation: _____

County: DESOTO
 Permit #: _____
 Driller: BOB SMITH
 Date completed: 4-17-13

This report be prepared by the pump installer in detail and filed with the Department within 30 days of completion of drilling of the well.

Well Owner Information	Well Location
Owner Name: <u>CHRISTE ELDER</u>	Latitude: _____ Longitude: _____
Mailing Address: <u>5205 TREAWANDA</u> <u>HERNANDO</u> <u>MS 38632</u>	Method of Lat/Long (circle one): Conventional Survey USGS quad, Hand-held GPS, survey grade GPS
City State Zip Code	<u>14</u> <u>14</u> Sec <u>P27</u> Twn <u>T35</u> Rng <u>R6W</u>
Telephone No. <u>(337) 277-3656</u>	Distance _____ miles Direction <u>S/W</u> Nearest Town <u>of COCKERM</u>

Pump Type Circle one	Power Type Circle one
Air lift Jet <input checked="" type="radio"/> <u>Submersible</u>	Diesel Engine Gasoline Engine Natural Gas
Bucket Piston Turbine	<input checked="" type="radio"/> <u>Electric Motor</u> Hand Tractor PTO
Centrifugal Rotary Flowing Well	Windmill Other(specify): _____
Other (specify): _____	Horse Power Rating of Motor: <u>3/4</u>
Date Pump Installed: <u>4-17-13</u>	Setting Depth: <u>120</u> feet
Rated Pump Capacity: <u>10</u> gallons per min	Number of Stages: <u>8</u>

Pump Test Data	Method of Measuring Water Level circle one
Date Well Tested: <u>4-17-13</u>	Air Line Electric Measuring Line Steel Tape
Static Water Level(A): <u>85</u> feet below Land Surface	Other(specify): <u>LINE + WEIGHT</u>
Pumping Water Level(B): _____ feet below Land Surface	
Drawdown[(B)-(A)]: _____ feet below Land Surface	For flowing well, measured shut in head: _____ feet
Test Pumping Rate: <u>12</u> gallons per Minute	Well yielded <u>12</u> GPM with a drawdown of _____ feet after _____ hours of pumping
Duration of Pump Test(minimum 4 hours): _____ hrs	


I HEREBY CERTIFY that the above statements are true to the best of my knowledge.

BOB SMITH 0-645 _____
 Print Name of Pump Installer and License No. Signature of Pump Installer

RECEIVED


MAY 14 2013

BY: OLWR

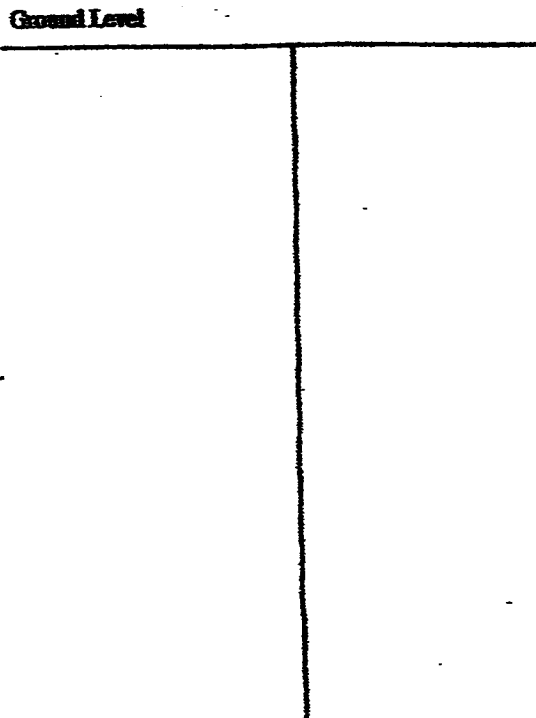

Description of Formations Encountered	From	To
TOP SOIL	0	5
BROWN CLAY	5	18
RED SAND & CLAY	18	42
GRAVEL	42	56
WHITE CLAY	56	115
WHITE SAND	115	135

If more than one screen, show location of each on sketch

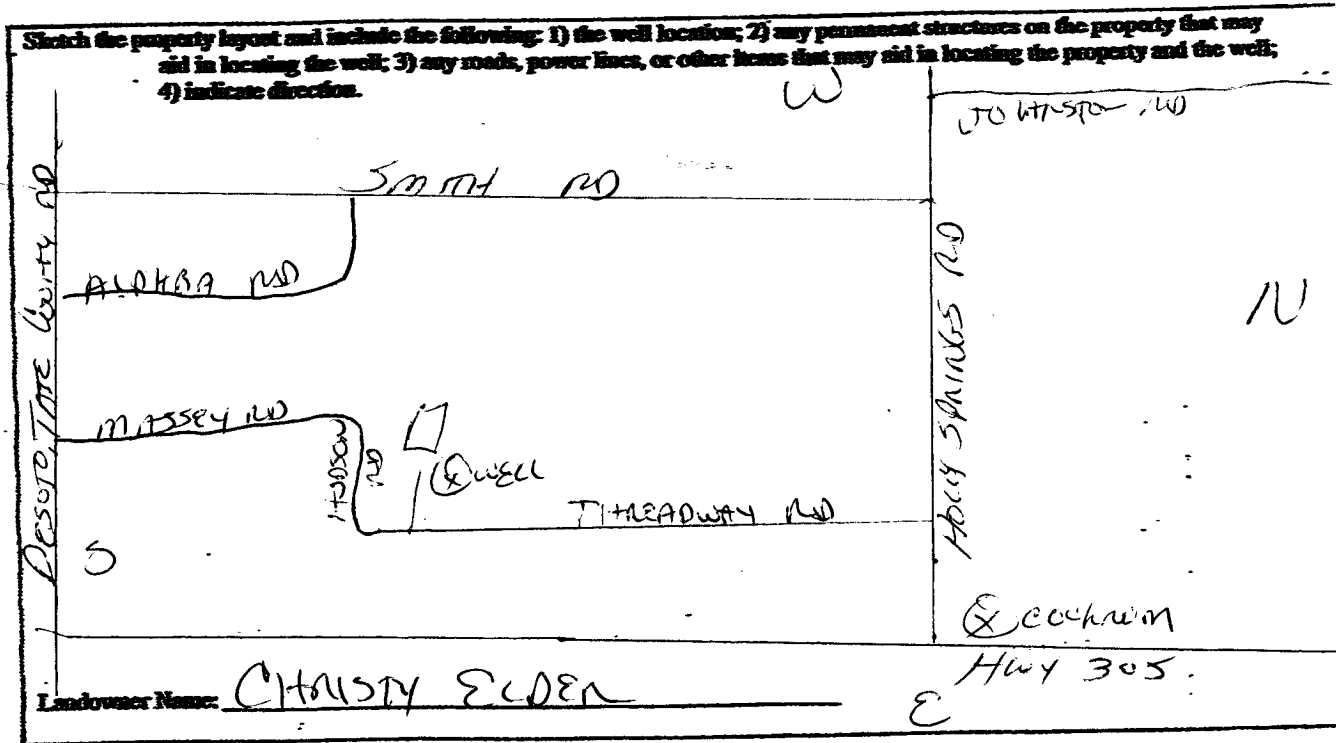

Signature of Water Well Contractor

RECEIVED
 MAY 14 2013
 BY: OLWR