	STATE 	VELL REPORT					
	STATE WELL REPORT Part 1		For Office Use Only:				
County:Cooto	ם ח	riller's Log	Well #:				
Permit #:	Mississippi Department of Environmental Quality		Aquifer:				
Driller: Jones w-Moson	Office of La	nd and Water Resources .0. Box 2309	E-Log #:				
Date drilling completed: 6_35-14	Jackso	n, MS 39225-2309	L LOS #				
		501)961-5210 \260-0535 (fax)					
(601)360-0535 (fax)							
State Law requires that this report be prepared by the license holder responsible for the work and filed with the Department at the above address within 30 days of completion of drilling of the well or borehole.							
Well Owner Information	tion	Well or Bore	ehole Location				
(Landowner if borehole is not for			ongitude: 89°41'21,75 W				
Owner Name: Trent Ross			49				
Mailing Address: 9427 thorn	Method of Latricing (check of						
	USGS quad, Hand-netd t		GPS <u>,</u> , Survey-grade GPS				
LOT 14 thorwridge	SUSAIUISON 11 SW 14 Sor		<u></u>				
Hervard o Ms City State	J0455						
			of <u>(Ockium</u> (Nearest Town)				
Telephone No. (901) 508-62	07	(Distance) (Direction)	(//////////////////////////////////////				
	Well / B	orehole Data					
Date drilling started: 6-25-14 Dat	e drilling completed	6-25-14 Hole depth: 140	D Hole diameter: <u>6314</u>				
Location of the source of any surface	water used for drim						
Method of dosing and volume of Chlo	rine used in drilling a	nd development: <u></u> <u>مم مم</u>	ord greater				
Logs run (circle all applicable): No log	run Electric Gam	ma Ray Density Sonic Neut	ron Other:				
Name of organization running log(s): NIA							
	Purpose of borehole (circle one): Water Well, Geotechnical/Geological Investigation Ground Source Heat Pump						
Seismic Survey Other (describe)							
If drilling is not related to water well construction, skip the remainder of this block							
Purpose of Well (circle all applicable): Home Industrial Public Supply Irrigation Fish Culture							
Other (describe):							
If a flowing well, method of flow regulation: Valve Other (describe) NH							
Static Water Level:feet [above or $below$] land surface Date measured:							
Method of measurement (circle one): Steel tape Electric tape Air line Other (describe): <u>3tring (weight</u>							
Well depth: 140 Well grouted to a depth of: 10 feet Type of grout (circle one): Neat Cement Bentonite Mix							
Casing length: 130 feet Casing diameter: 4 inches Type of casing: post							
Screen length: () feet Screen diameter:(inches Type of screen:							
Screen slot size:							
Type of completion (circle all applicable): Gravel packed Underreamed Open hole Natural Development							
Other (describe):							
Top of lap pipe or reduction in casing: $\underline{\mathcal{N}}(\mathcal{A})$ feet							
If telescoped or more than one screen, describe on next page							

ı

L

;

County: _	Desoto
Permit #:	

For Office Use Only:

The sketch below only required for water wells


If well telescopes, show depths on sketch.

Ground Level

Description of formations encountered must be provided for all wells and boreholes, unless specifically exempted by regulations

scription of Formations Encountered	From (<i>dep<u>th</u></i>)	To (depth
cley dirt	Ground level	10
Grand	10	20
grael white sound	30	50
white day	50	60
white clay white soud	60	140
		ļ
		<u> </u>
		<u> </u>
······		

If more than one screen, show location of each on sketch

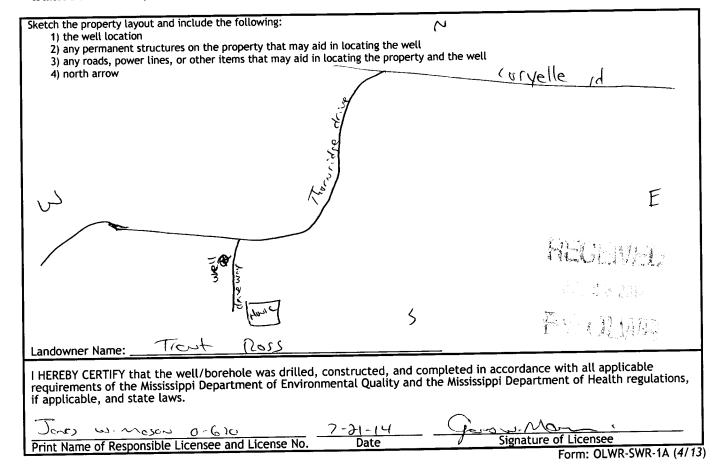

STATE WELL REPORT						
County: Deseto		Part 2	For Office Use Only:			
Permit #:	Pump Installe	r's Completion Report	Well #:			
Driller: Jones w. Mason	Mississippi Departm	nent of Environmental Quality ad and Water Resources	Well #:			
_	P.	.O. Box 2309	Aquifer:			
Date completed: 6-25-14	Jackso	n, MS 39225-2309 601)961-5210	Aquilet:			
<u>Copy information from block on Part 1</u>) 360-0535 (fax)				
This part of the report must be complete	d by a licensed water	well contractor or a licensed pu	mp installer. A copy of Part 1			
of the report must be attached and both	parts filea with the D	epuriment ut the above addites	within 30 days of well completion.			
Well Owner Information		Went				
Owner Name: Treat Ross.		Latitude: <u>34 ° 48'ə5, 49 ~</u> Loi	ngitude: <u>89° 41'21.75</u> W			
Mailing Address: 9427 thorwridge drive		Method of Lat/Long (check one): Conventional Survey,				
LOT 14 thorward pe s	ubdiviso~	USGS quad, Hand-held GPS, Survey-grade GPS				
Henarto MS City State	39,033	NE 14 5W 14, Sec_	22 T_35_R_6W			
-		12_Miles NW C	Miles <u>Nw</u> of <u>Cockerum</u> (Direction) (Nearest Town)			
Telephone No. (<u> </u>	<u>))</u>	(Distance) (Direction)	(Nearest Town)			
	Pump Ty	pe (circle one)				
Submersible) Turbine Air Lift Centri	fugal Flowing Well	Jet Piston Rotary Other (d	escribe):			
Date Pump Installed: $(3-35-14)$		Rated Pump Capacity:	Gallons Per Minute			
Is This Pump (circle one): New Re	Power Ty	vpe (circle one)				
Electric Diesel Gasoline Natural Ga	s Tractor PTO Wir	ndmill Other (describe):				
Horse Power Rating of Motor:3	Setting Den	th: 80 feet Numbe	er of Stages: <u> </u>			
Horse Power Rating of Motor:						
	Pump Test Data	for Non Flowing Well	thours thours			
Date Well Tested: <u>$G=35-14$</u> Duration of Pump Test (<i>minimum 4 hours</i>): <u>$\exists 4$</u> hours						
Static Water Level (A): \underline{S} Feet Below Land Surface Pumping Water Level (B): $\underline{\alpha'}$ Feet Below Land Surface						
Drawdown [(B) - (A)]: رم	_Feet Below Land Su	rface Test Pumping Rate:	Gallons Per Minute			
Method of measurement (circle one):	Steel tape Electric (ape Air line Other (describe)	String meight			
	Pump Test Da	ata for Flowing Well				
Measured shut in head: $\underline{\sim}$	et.	2.1				
Well vielded ()GPM with a	drawdown of	104 feet after 34	hours of pumping			
Measured shut in head. feet after hours of pumping Well yielded GPM with a drawdown of feet after hours of pumping Meter Installation						
Meter Serial Number:						
Meter Manufacturer:		Type of Meter:	N14			
Meter Model Number/Name: Type of Meter: N(4 Type of Meter: N(4 N(4)))						
Meter Model Number Name:						
Installation Date: Meter installed by:/A						
Is This Meter (circle one): New Repaired Replacement Important: By submitting the above information you are certifying that this meter was installed to manufacturer standards.						
Important: By submitting the above For agricul	information you are tural wells, a list of a	certifying that this meter was ins pproved meters is on the MDEQ	talled to manufacturer standards. website.			
I HEREBY CERTIFY that the above statements are true to the best of my knowledge.						
			1. Mar			
Frint Name of Pump Installer and Lice	ense No. (if applicable	le) Date Sig	nature of Pump Installer			
Find Name of Fump instance and Elec	·····		Form: OLWR-SWR-1B (4/13			

٠

•