

# STATE WELL REPORT

314

County: Desoto  
 Permit #: \_\_\_\_\_  
 Driller: Jones W. Mason  
 Date drilling completed: 9-18-18

**Part 1**  
**Driller's Log**  
 Mississippi Department of Environmental Quality  
 Office of Land and Water Resources  
 P.O. Box 2309  
 Jackson, MS 39225-2309  
 (601)961-5210  
 (601)360-0535 (fax)

**For Office Use Only:**

Well #: M456  
 Aquifer: \_\_\_\_\_  
 E-Log #: \_\_\_\_\_

*State Law requires that this report be prepared by the license holder responsible for the work and filed with the Department at the above address within 30 days of completion of drilling of the well or borehole.*

Well Owner Information <small>(Landowner if borehole is not for a water well)</small>	Well or Borehole Location
Owner Name: <u>Shone Hughes</u>	Latitude: <u>34°48'32.70"N</u> Longitude: <u>89°44'24.41"W</u>
Mailing Address: <u>14003 Cathy rd.</u> <u>Cathy</u>	Method of Lat/Long (check one): Conventional Survey _____, USGS quad _____, Hand-held GPS <input checked="" type="checkbox"/> , Survey-grade GPS _____
<u>Byholia</u> <u>Ms</u> <u>38611</u>	<u>NW</u> 1/4 <u>SW</u> 1/4, Sec <u>21</u> T <u>33</u> R <u>5W</u>
City State Zip Code	<u>1 1/2</u> Miles <u>SW</u> of <u>Ingers Mill</u>
Telephone No. <u>(901) 497-6302</u>	(Distance) (Direction) (Nearest Town)

**Well / Borehole Data**

Date drilling started: 9-18-18 Date drilling completed: 9-18-18 Hole depth: 110' Hole diameter: 7"

Location of the source of any surface water used for drilling: N/A

Method of dosing and volume of Chlorine used in drilling and development: 50 ppm and greater

Logs run (circle all applicable):  No log run  Electric  Gamma Ray  Density  Sonic  Neutron  Other: \_\_\_\_\_

Name of organization running log(s): N/A

Purpose of borehole (circle one):  Water Well  Geotechnical/Geological Investigation  Ground Source Heat Pump  
 Seismic Survey  Other (describe) \_\_\_\_\_

*If drilling is not related to water well construction, skip the remainder of this block*

Purpose of Well (circle all applicable):  Home  Industrial  Public Supply  Irrigation  Fish Culture

Other (describe): N/A

If a flowing well, method of flow regulation: Valve N/A Other (describe) N/A

Static Water Level: 15 feet [above or  below] land surface (circle one) Date measured: 9-18-18

Method of measurement (circle one): Steel tape  Electric tape  Air line  Other (describe): String level

Well depth: 110 Well grouted to a depth of: 50 feet Type of grout (circle one): Neat Cement   Bentonite  Mix

Casing length: 90 feet Casing diameter: 4 inches Type of casing: pvc

Screen length: 20 feet Screen diameter: 4 inches Type of screen: pvc

Screen slot size: .010 inches Setting depth: From 90 feet to 110 feet

Type of completion (circle all applicable):  Gravel packed  Underreamed  Open hole  Natural Development

Other (describe): N/A

Top of lap pipe or reduction in casing: N/A feet


*If telescoped or more than one screen, describe on next page*

County: \_\_\_\_\_  
 Permit #: \_\_\_\_\_

**For Office Use Only:**  
 Well #: M456

The sketch below only required for water wells


If well telescopes, show depths on sketch.

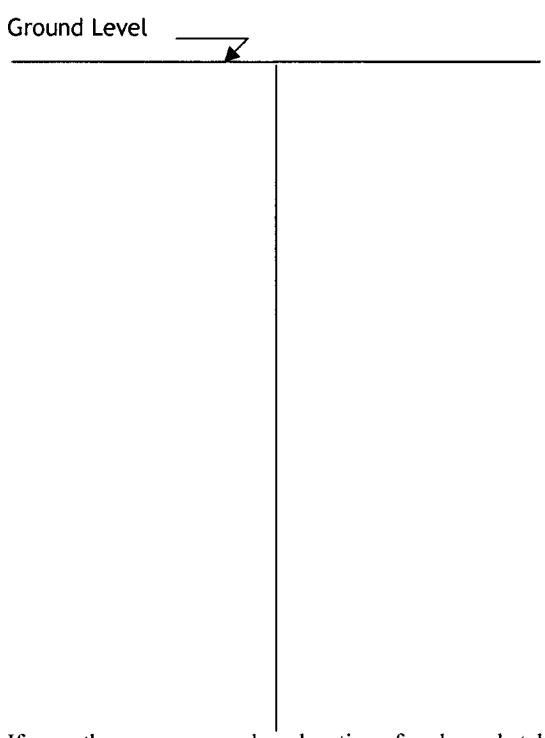

Description of formations encountered must be provided for all wells and boreholes, unless specifically exempted by regulations

Description of Formations Encountered	From (depth)	To (depth)
clay dirt	Ground level	20
white sand	20	110

If more than one screen, show location of each on sketch

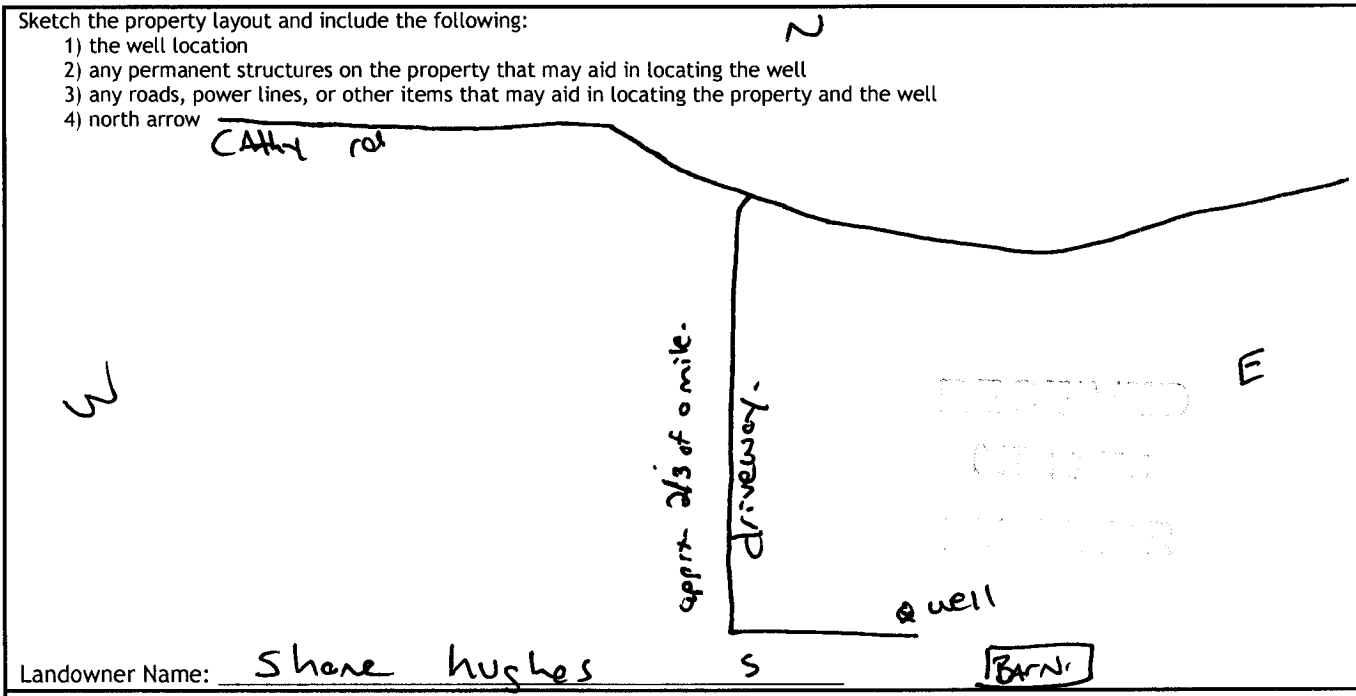

I HEREBY CERTIFY that the well/borehole was drilled, constructed, and completed in accordance with all applicable requirements of the Mississippi Department of Environmental Quality and the Mississippi Department of Health regulations, if applicable, and state laws.

Jones W-Mason 0-620      10-17-18      Jones W-Mason  
 Print Name of Responsible Licensee and License No.      Date      Signature of Licensee

# STATE WELL REPORT

## Part 2

**Pump Installer's Completion Report**  
Mississippi Department of Environmental Quality  
Office of Land and Water Resources  
P.O. Box 2309  
Jackson, MS 39225-2309  
(601)961-5210  
(601) 360-0535 (fax)

### For Office Use Only:

Well #: M456  
Aquifer: \_\_\_\_\_

County: Oesoto  
Permit #: \_\_\_\_\_  
Driller: Jones w. Meason  
Date completed: 9-18-18  
Copy information from block on Part 1

*This part of the report must be completed by a licensed water well contractor or a licensed pump installer. A copy of Part 1 of the report must be attached and both parts filed with the Department at the above address within 30 days of well completion.*

Well Owner Information	Well Location
Owner Name: <u>Shome Hughes</u>	Latitude: <u>34°48'32.70"N</u> Longitude: <u>89°44'24.41"W</u>
Mailing Address: <u>14003 Cathy rd.</u>	Method of Lat/Long (check one): Conventional Survey _____, USGS quad _____, Hand-held GPS <input checked="" type="checkbox"/> , Survey-grade GPS _____
<u>Byholia</u> <u>ms</u> <u>38611</u>	<u>NW</u> ¼ <u>SW</u> ¼, Sec <u>21</u> T <u>3s</u> R <u>5w</u>
City State Zip Code	<u>1 1/2</u> Miles <u>Sw</u> of <u>Ingrans mill</u>
Telephone No. ( <u>901</u> ) <u>497-6302</u>	(Distance) (Direction) (Nearest Town)

### Pump Type (circle one)

Submersible  Turbine  Air Lift  Centrifugal  Flowing Well  Jet  Piston  Rotary  Other (describe): \_\_\_\_\_  
Date Pump Installed: 9-18-18 Rated Pump Capacity: 22 Gallons Per Minute  
Is This Pump (circle one):  New  Repaired  Replacement

### Power Type (circle one)

Electric  Diesel  Gasoline  Natural Gas  Tractor PTO  Windmill  Other (describe): \_\_\_\_\_  
Horse Power Rating of Motor: 1.5 Setting Depth: 60 feet Number of Stages: 6

### Pump Test Data for Non Flowing Well

Date Well Tested: 9-18-18 Duration of Pump Test (minimum 4 hours): 24 hours  
Static Water Level (A): 15 Feet Below Land Surface Pumping Water Level (B): N/A Feet Below Land Surface  
Drawdown [(B) - (A)]: N/A Feet Below Land Surface Test Pumping Rate: 22 Gallons Per Minute  
Method of measurement (circle one):  Steel tape  Electric tape  Air line  Other (describe): String / weight

### Pump Test Data for Flowing Well

Measured shut in head: N/A feet.  
Well yielded 22 GPM with a drawdown of N/A feet after 24 hours of pumping

### Meter Installation

Meter Manufacturer: N/A Meter Serial Number: N/A  
Meter Model Number/Name: N/A Type of Meter: N/A  
Totalizer Register Unit and Multiplier Factor (AF x .001, gal x 1000, etc): N/A  
Installation Date: N/A Meter installed by: N/A  
Is This Meter (circle one):  New  Repaired  Replacement

**Important:** By submitting the above information you are certifying that this meter was installed to manufacturer standards. For agricultural wells, a list of approved meters is on the MDEQ website.

I HEREBY CERTIFY that the above statements are true to the best of my knowledge.

Jones w. Meason 0-620 10-17-18 Jones w. Meason  
Print Name of Pump Installer and License No. (if applicable) Date Signature of Pump Installer