

STATE WELL REPORT

Part 1

Driller's Log

Mississippi Department of Environmental Quality
 Office of Land and Water Resources
 P.O. Box 2309
 Jackson, MS 39225-2309
 (601)961-5210
 (601)360-0535 (fax)

For Office Use Only:

Well #: M 529
 Aquifer: _____
 E-Log #: _____

County: Desoto
 Permit #: _____
 Driller: Joey W. Masen
 Date drilling completed: 12-30-20

State Law requires that this report be prepared by the license holder responsible for the work and filed with the Department at the above address within 30 days of completion of drilling of the well or borehole.

Well Owner Information <i>(Landowner if borehole is not for a water well)</i>	Well or Borehole Location
Owner Name: <u>Kenny Dunlap</u>	Latitude: <u>34°49'28.88"N</u> Longitude: <u>89°44'55.70"W</u>
Mailing Address: <u>13405 Strickland rd</u>	Method of Lat/Long (check one): Conventional Survey _____, USGS quad _____, Hand-held GPS _____, Survey-grade GPS _____
<u>Byhalia</u> <u>MS</u> <u>38611</u>	<u>5E^{SW} 1/4 NW 1/4, Sec 17 T 3S R 5W</u>
City State Zip Code	<u>1</u> Miles <u>E</u> of <u>Ingrams mill</u>
Telephone No. <u>(901) 490-3066</u>	(Distance) (Direction) (Nearest Town)

Well / Borehole Data

Date drilling started: 12-30-20 Date drilling completed: 12-30-20 Hole depth: 160 Hole diameter: 7"
 Location of the source of any surface water used for drilling: NA
 Method of dosing and volume of Chlorine used in drilling and development: 50 ppm or greater
 Logs run (circle all applicable): No log run Electric Gamma Ray Density Sonic Neutron Other: _____
 Name of organization running log(s): NA
 Purpose of borehole (circle one): Water Well Geotechnical/Geological Investigation Ground Source Heat Pump
 Seismic Survey Other (describe) NA

If drilling is not related to water well construction, skip the remainder of this block

Purpose of Well (circle all applicable): Home Industrial Public Supply Irrigation Fish Culture
 Other (describe): NA
 If a flowing well, method of flow regulation: Valve NA Other (describe) _____
 Static Water Level: 48 feet [above or below] land surface Date measured: 12-30-20
 (circle one)
 Method of measurement (circle one): Steel tape Electric tape Air line Other (describe): string weight
 Well depth: 160 Well grouted to a depth of: 50 feet Type of grout (circle one): Neat Cement Bentonite Mix
 Casing length: 140 feet Casing diameter: 4 inches Type of casing: pvc
 Screen length: 20 feet Screen diameter: 4 inches Type of screen: pvc
 Screen slot size: 0.010 inches Setting depth: From 140 feet to 160 feet
 Type of completion (circle all applicable): Gravel packed Underreamed Open hole Natural Development
 Other (describe): NA
 Top of lap pipe or reduction in casing: NA feet

If telescoped or more than one screen, describe on next page


RECEIVED
 FEB 02 2021
 BY OLWR

County: _____
 Permit #: _____

For Office Use Only:
 Well #: _____


The sketch below only required for water wells
If well telescopes, show depths on sketch.

Description of formations encountered must be provided for all wells and boreholes, unless specifically exempted by regulations

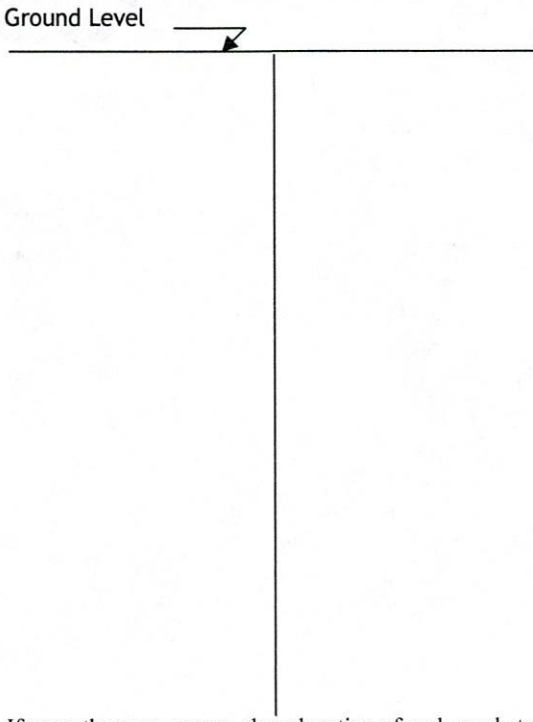

Description of Formations Encountered	From (depth)	To (depth)
clay dirt	Ground level	15
hard rock	15	18
white sand	18	160

If more than one screen, show location of each on sketch

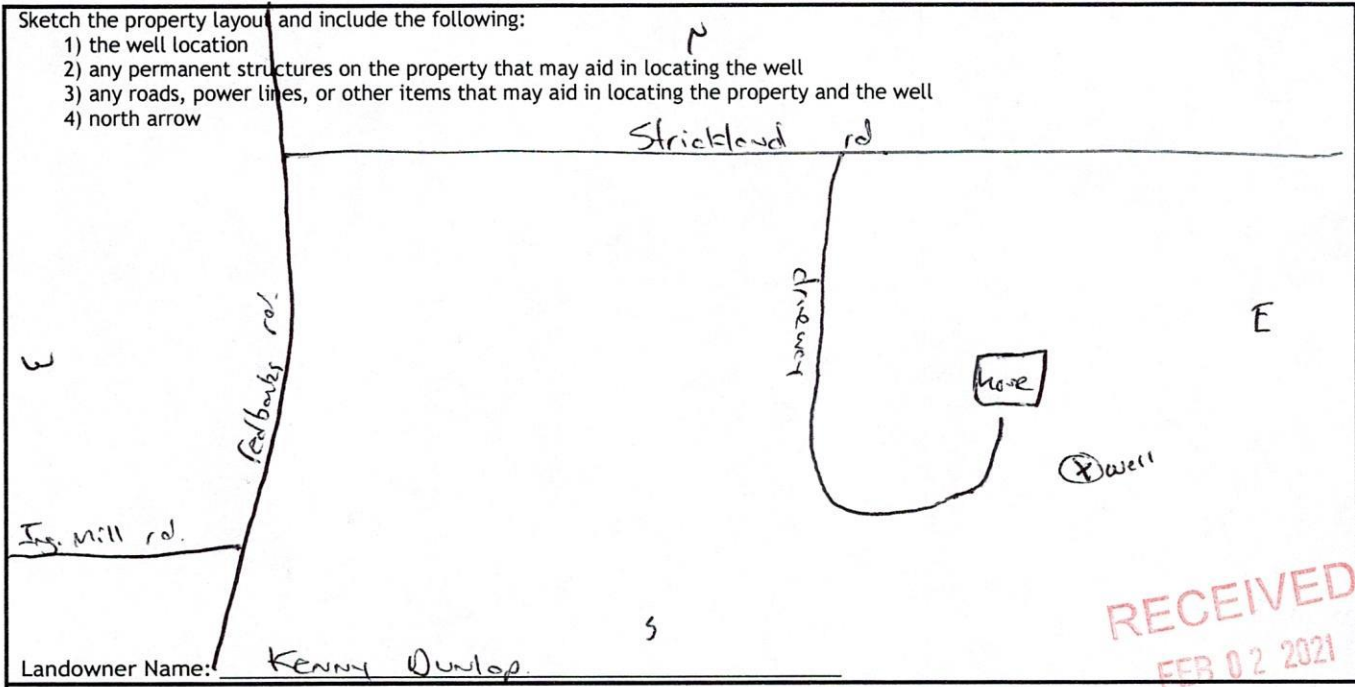

I HEREBY CERTIFY that the well/borehole was drilled, constructed, and completed in accordance with all applicable requirements of the Mississippi Department of Environmental Quality and the Mississippi Department of Health regulations, if applicable, and state laws.

Joe W. Mason 0-620 1-26-21 Joe W. Mason
 Print Name of Responsible Licensee and License No. Date Signature of Licensee

RECEIVED
 FEB 02 2021
 BY [Signature]

STATE WELL REPORT

Part 2

Pump Installer's Completion Report
 Mississippi Department of Environmental Quality
 Office of Land and Water Resources
 P.O. Box 2309
 Jackson, MS 39225-2309
 (601)961-5210
 (601) 360-0535 (fax)

For Office Use Only:

Well #: M529
 Aquifer: _____

County: Okecho
 Permit #: _____
 Driller: Jones w. Mason
 Date completed: 12-30-20
Copy information from block on Part 1

This part of the report must be completed by a licensed water well contractor or a licensed pump installer. A copy of Part 1 of the report must be attached and both parts filed with the Department at the above address within 30 days of well completion.

Well Owner Information	Well Location
Owner Name: <u>Kenny Dunlap</u>	Latitude: <u>34° 49' 28.88" N</u> Longitude: <u>89° 44' 55.70" W</u>
Mailing Address: <u>13405 Strickland rd</u>	Method of Lat/Long (check one): Conventional Survey _____, USGS quad <u>5E SW NE</u> Hand-held GPS <input checked="" type="checkbox"/> , Survey-grade GPS _____
<u>Bahalia</u> <u>ms</u> <u>38611</u>	<u>5E SW NE</u> 1/4 <u>NE</u> 1/4, Sec <u>17</u> T <u>3S</u> R <u>5W</u>
City State Zip Code	<u>1</u> Miles <u>E</u> of <u>Ingram's Mill</u>
Telephone No. <u>(901) 490-3066</u>	(Distance) (Direction) (Nearest Town)

Pump Type (circle one)

Submersible Turbine Air Lift Centrifugal Flowing Well Jet Piston Rotary Other (describe): _____

Date Pump Installed: 12-30-20 Rated Pump Capacity: 20 Gallons Per Minute

Is This Pump (circle one): New Repaired Replacement

Power Type (circle one)

Electric Diesel Gasoline Natural Gas Tractor PTO Windmill Other (describe): _____

Horse Power Rating of Motor: 1.5 Setting Depth: 80 feet Number of Stages: 10

Pump Test Data for Non Flowing Well

Date Well Tested: 12-30-20 Duration of Pump Test (minimum 4 hours): 24 hours

Static Water Level (A): 48 Feet Below Land Surface Pumping Water Level (B): N/A Feet Below Land Surface

Drawdown [(B) - (A)]: N/A Feet Below Land Surface Test Pumping Rate: 20 Gallons Per Minute

Method of measurement (circle one): Steel tape Electric tape Air line Other (describe): String weight

Pump Test Data for Flowing Well

Measured shut in head: N/A feet.

Well yielded 20 GPM with a drawdown of N/A feet after 24 hours of pumping

Meter Installation

Meter Manufacturer: N/A Meter Serial Number: N/A

Meter Model Number/Name: N/A Type of Meter: N/A

Totalizer Register Unit and Multiplier Factor (AF x .001, gal x 1000, etc): N/A

Installation Date: N/A Meter installed by: N/A

Is This Meter (circle one): New Repaired Replacement

RECEIVED
FEB 02 2021
BY OLWF

Important: By submitting the above information you are certifying that this meter was installed to manufacturer standards. For agricultural wells, a list of approved meters is on the MDEQ website.

I HEREBY CERTIFY that the above statements are true to the best of my knowledge.

Jones w. Mason 0-620 1-26-21 Jones w. Mason
 Print Name of Pump Installer and License No. (if applicable) Date Signature of Pump Installer