

M 200

WATER WELL DRILLERS LOG

8-22-62

Date: Aug 22, 1962, Driller: M H H - [unclear] County: [unclear]

AC Kle [unclear] (Name)

(1) Owner of Land: Conest. Sewell
 (Name)
circumfered - miss
 (Address)

(2) Location: 1/4, 1/4, Sec. 18 T 3 R 2
15 mi E, of Hammond
 (distance) (direction) (Nearest Town)

(3) Topography: X
 (Hilly) (Flat) (Level)


(4) Purpose of Well: Home
 (Domestic Irrigation
 Municipal, Industrial, Other)

| Description & Color of Materials Sand, Clay, Red Clay, Shell, etc. | Thick- ness Feet | Depth Feet |
|---|------------------------|---------------|
| Red clay | 30 | 67 |
| White sand + clay | | |

Information upon completion of well:

- (1) Diameter 2 inches.
- (2) Total Depth 89' feet.
- (3) Water Level 63 feet below top of ground.
- (4) Cased to 83', Size 2
- (5) Screen: Size 1/4, Length 6'
- (6) Were any formations sealed against pollution?
 _____ yes, _____ no.

Jet
FOC 52

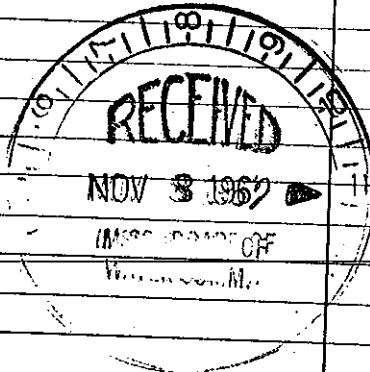

If YES depth of formation _____

Why _____

Drillers Remarks: _____

Well No. 24

(Use Back Side)

Retain this copy for your office files.