

DESOTO MISSISSIPPI BOARD OF WATER COMMISSIONERS

M 2507

3-24-65

WATER WELL DRILLERS LOG

Date: 3-24, 1965, Driller: Harris Bros. County _____

(Name)

(1) Owner of Land:	Description & Color of Materials Sand, Clay, Red Clay, Shell, etc.	Thick- ness Feet	Depth Feet
P. D. Spiers (Name)	top soil	0	20
Ingram Mills, Miss. (Address)	red sand	20	60
(2) Location: _____ 1/4, _____ 1/4, Sec. T3 R6	clay & sand strips	60	115
_____ miles _____, of _____ (distance) (direction) (Nearest Town)	coarse white sand	115	130
(3) Topography: _____ (Hilly) (Flat) (Level)			
(4) Purpose of Well: domestic (Domestic Irrigation Municipal, Industrial, Other)			

Information upon completion of well:

(1) Diameter 4 inches.

(2) Total Depth 130 feet.

(3) Water Level ~~13~~ 80 feet below top of ground.

(4) Cased to 123, Size 4"


(5) Screen: Size 4", Length 7'

(6) Were any formations sealed against pollution?
_____ yes, _____ no.

If YES depth of formation _____

Why _____

Drillers Remarks: _____

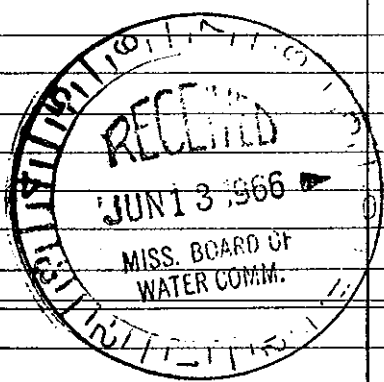

Well No.

(Use Back Side)

Mail this copy to Board of Water Commissioners 429 Miss. St. Jackson, Miss.