

MISSISSIPPI DEPARTMENT OF NATURAL RESOURCES

Bureau of Land and Water Resources

Southport Mall

P.O. Box 10631

Jackson, Mississippi 39209

WATER WELL DRILLERS LOG

DESO
M
2064

8-4 1986 860 Russell White Well Desoto
date well completed firm name county well located


LANDOWNER: <u>William Smith</u>	description of formations encountered	from	to
<u>6980 Alpha Rd.</u> <u>Coldwater, ms</u> (mailing address)			
	<u>top soil</u>	<u>0'</u>	<u>2'</u>
	<u>Red clay</u>	<u>2'</u>	<u>20'</u>
	<u>Red sand gravel</u>	<u>20'</u>	<u>33'</u>
	<u>White sand</u>	<u>33'</u>	<u>140'</u>

WELL LOCATION:
sec. 29 T 3 N R 6 E
12 miles East of Merido
(distance) (direction) (nearest town)

WELL PURPOSE: home
(home, irrigation, municipal, industrial)

- WELL COMPLETION DATA:
- (1) diameter (inches) 4"
 - (2) total depth (feet) 140
 - (3) static water level (feet) 90 ^{below} _{above} top of ground.
 - (4) casing PVC, 130
(material), (depth)
4"
(size) If telescope see back.
 - (5) screen 10, 130'
(length), (depth to top)
4", PVC
(size), (material)
 - (6) pump 3/4, 10
(HP), (yield gpm)
Elec
(type power)
 - (7) electric log No
(yes or no)
 - (8) how well bottom plugged Cap

DRILLERS REMARKS:

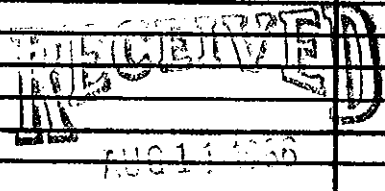

Department of Natural Resources
Bureau of Land & Water Resources