

FORREST MISSISSIPPI BOARD OF WATER COMMISSIONERS

A 26 (3)
4-10-66

WATER WELL DRILLERS LOG

Date: 4-10-1966, Driller: J. St. R. Drilling
County: FORREST

(1) Owner of Land (Name)	Description & Color of Materials Sand, Clay, Red Clay, Shell, etc.	Thick- ness Feet	Depth Feet
Mr. Cecil R. Muller	Red Clay	28	28
Box 204 Rt 1 Hattiesburg, Miss	White Clay	37	65
SW Corner of SW 1/4, Sec. 5 T5 R14, N W	Stagnant fine sand blue clay	22	87
7 miles North of Hattiesburg	Blue Clay	128	215
(distance) (direction) (Nearest Town)	Blue Shell	145	360
(3) Topography: Hilly	White Sand	70	430
(4) Purpose of Well: Home			
(Domestic Irrigation Municipal, Industrial, Other)			

Information upon completion of well:


- (1) Diameter 2 inches.
- (2) Total Depth 430 feet.
- (3) Water Level 604 feet below top of ground.
- (4) Cased to 420, Size 2"
- (5) Screen: Size 2", Length 10 ft.
- (6) Were any formations sealed against pollution?
yes, no.

If YES depth of formation _____

Why _____

Drillers Remarks: _____

This well has
Surface casing 17 ft
Surface Cement 15 ft

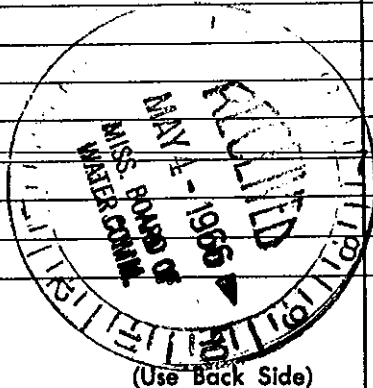

(Use Back Side)

Well No. 17