

FORREST MISSISSIPPI BOARD OF WATER COMMISSIONERS

A 27 (6)
8-24-61

WATER WELL DRILLERS LOG

Date: 8 24, 1961, Driller:

County Forrest

(1) Owner of Land: Willie Landrum
(Name)
At. 7 - H'BURG MISS.
(Address)

Description & Color of Materials Sand, Clay, Red Clay, Shell, etc.	Thick- ness Feet	Depth Feet
<u>RED CLAY</u>	<u>15</u>	<u>15</u>
<u>WHITESAND</u>	<u>30</u>	<u>45</u>
<u>SANDY GRAVE</u>	<u>28</u>	<u>73</u>

(2) Location: $\frac{1}{4}$, $\frac{1}{4}$, Sec. 28 T5 N R14 W
4 miles NORTH-W. of H'BURG
(distance) (direction) (Nearest Town)

(3) Topography: FIAT
(Hilly) (Flat) (Level)

(4) Purpose of Well: DOMESTIC
(Domestic Irrigation
Municipal, Industrial, Other)


Information upon completion of well:

- (1) Diameter 4 inches.
- (2) Total Depth 73 feet.
- (3) Water Level 42 feet below top of ground.
- (4) Cased to 73', Size 4"
- (5) Screen: Size 4", Length 5'
- (6) Were any formations sealed against pollution?
no yes, no no.

If YES depth of formation _____

Why _____

Drillers Remarks: _____

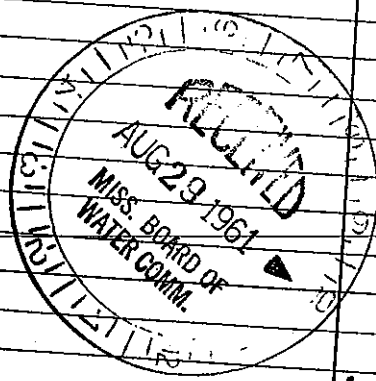

31

Well No.

(Use Back Side)

Mail this copy to Board of Water Commissioners 429 Miss. St. Jackson, Miss.