

FORREST
A 61
10-1-75

MISSISSIPPI
BOARD OF WATER COMMISSIONERS
416 North State Street
Jackson, Mississippi 39201

CODED

WATER WELL DRILLERS LOG


10-1-1975 date well completed
L. J. Searl Drilling Services firm name
Forrest county well located

LANDOWNER	description of formations encountered	from	to
Richard D. 7 Box 270 A Hattiesburg miss. (mailing address)	fine sand	0	10
	clay	10	102
	fine sand	102	110
	fine sand	110	117

WELL LOCATION:
sec. 4 T 5 N R 14 E
S W
5 miles N Hattiesburg Standard
(distance) (direction) (nearest town)

WELL PURPOSE: Home
(home, irrigation, municipal, industrial)

- WELL COMPLETION DATA:
- (1) diameter (inches) 2"
 - (2) total depth (feet) 117
 - (3) static water level (feet) 107 below above top of ground.
 - (4) casing Plastic 107 ft (material) (depth)
2" (size) if telescope see back.
 - (5) screen 107 ft 117 (length) (depth to top)
2" Plastic (size) (material)
 - (6) pump 1 1/2 (HP) 10 (yield gpm)
900 (type power)
 - (7) electric log (yes or no)
(organization running log)
 - (8) how well bottom plugged (yes or no)

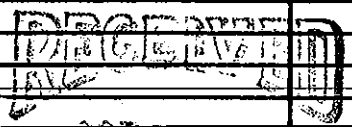

DRILLERS REMARKS:
MISS. BD. OF WATER COMM