

OCT-17-2002 10:24A FROM:

TD: 16013600535

P: 4

### State Well Report

#### Part 1

Mississippi Department of Environmental Quality  
Office of Land and Water Resources  
P.O. Box 10631  
Jackson, MS 39289-0631  
(601)961-5210  
(601)354-6938 (fax)

County: Jordan  
 Permit #: \_\_\_\_\_  
 Driller: Travis Boone  
 Date drilling completed: 9-17-07

For Office Use Only:  
 Aquifer: \_\_\_\_\_  
 Well #: A 97  
 L.S. Elevation: \_\_\_\_\_  
 B-log #: \_\_\_\_\_

State Law requires that this report be prepared by the driller in detail and filed with the Department within 30 days of completion of drilling of the well.

Well Owner Information	Well Location
Owner Name: <u>Mama Fair</u>	Latitude: _____ Longitude: _____
Mailing Address: <u>112 Lake Shore Dr.</u> <u>Hattiesburg, ms</u>	Method of Lat/Long (circle one): <u>Conventional Survey</u> USGS quad, Hand-held GPS, Survey-grade GPS
City: <u>39402</u> State: _____ Zip Code: _____	<u>4</u> <u>4</u> Sec <u>34</u> Twn <u>5N</u> Rng <u>14W</u>
Telephone No. (_____) _____	Distance Direction Nearest Town <u>5 1/2</u> Miles <u>NW</u> of <u>Hattiesburg</u>

**Well Data**

Purpose of Well (circle one): Home Industrial Public Supply Irrigation Fish Culture Other: \_\_\_\_\_

Date well drilling started: 9-17-07 Date well drilling completed: 9-17-07

If flowing, method of flow regulation: Valve \_\_\_\_\_ Other (describe) \_\_\_\_\_

Static Water Level: 60 feet above or below (circle one) land surface Date measured: 9-17-07

Method of Measurement (circle one) steel tape electric tape air line other: String Line

Hole depth: \_\_\_\_\_ Well depth: 185 Well grouted to a depth of 10 feet

Type of grout (circle one): Cement Bentonite Mix

Casing length: 165 feet Casing diameter: 4 inches Type of casing: sch 40

Screen length: 20 feet Screen diameter: 4 inches Type of screen: sch 40

Screen slot size: 8 inches Setting depth: From 165 feet to 185 feet

Type of completion (circle all applicable): Gravel packed Underdrained Telescoped Open hole Natural Development  
Other (describe): \_\_\_\_\_

Top of tap pipe or reduction in casing: \_\_\_\_\_ feet. If telescoped or more than one screen, describe on back of page

Logs run (circle all applicable): No log run Electric Gamma Ray Density Sonic Neutron Other: \_\_\_\_\_

Name of organization running log(s): \_\_\_\_\_

I certify that the well was drilled, constructed, and completed in accordance with all applicable requirements of the Mississippi Department of Environmental Quality and/or the Mississippi Department of Health regulations and state laws.

Travis Boone 0-514 \_\_\_\_\_  
 Print Name of Water Well Contractor and License No. Signature of Water Well Contractor

RECEIVED  
 OCT 17 2007  
 BY: OLWR

OCT-17-2002 10:25A FROM:


TO: 16013600535

P:6

A-97

If well telescopes please sketch below and show depths.

Ground Level

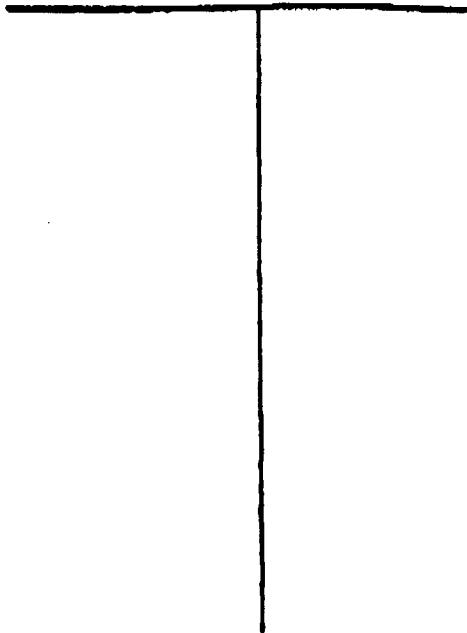

Description of Formations Encountered

From To

Description of Formations Encountered	From	To
Clay	0	100
sand + g gravel	100	135

If more than one screen, show location of each on sketch

Sketch the property layout and include the following: 1) the well location; 2) any permanent structures on the property that may aid in locating the well; 3) any roads, power lines, or other items that may aid in locating the property and the well; 4) Indicate direction.

Landowner Name: Mona Fair

  
Signature of Water Well Contractor

RECEIVED  
OCT 17 2007  
BY: OLWR

OCT-17-2002 10:24A FROM:

TO: 16013600535

P:5

### STATE WELL REPORT

#### Part 2

**Pump Installer's Completion Report**  
 Mississippi Department of Environmental Quality  
 Office of Land and Water Resources  
 P.O. Box 10631  
 Jackson, MS 39209-0631  
 (601)961-5210  
 (601)354-6938 (fax)

County: Jones  
 Permit #: \_\_\_\_\_  
 Installer: Travis Boone  
 Date completed: 9-17-07

**For Office Use Only**  
 Aquifer: \_\_\_\_\_  
 Well #: A-97  
 Elevation: \_\_\_\_\_

This report should be prepared by the pump installer in detail and filed with the Department within 30 days of the completion of pump.

Well Owner Information	Well Location
Owner Name: <u>Memo Fair</u>	Latitude: _____ Longitude: _____
Mailing Address: <u>112 Lake Shore Dr</u>	Method of Lat/Long (circle one): <u>Conventional Survey</u>
<u>Hattiesburg ms</u>	USGS quad, Hand-held GPS, Survey-grade GPS
<u>39402</u>	<u>4 Sec 34 Twa 5N Rng 14W</u>
City State Zip Code	Distance Direction Nearest Town
Telephone No. ( ) _____	<u>5 1/2 Miles NW of Hattiesburg</u>

Pump Type Circle one	Power Type Circle one
Air Lift Jet <u>Submersible</u>	Diesel Engine Gasoline Engine Natural Gas
Bucket Piston Turbine	<u>Electric Motor</u> Hand Tractor PTO
Centrifugal Rotary Flowing Well	Windmill Other (specify): _____
Other (specify): _____	Horse Power Rating of Motor: <u>1 1/2</u>
Date Pump Installed: <u>9-17-07</u>	Setting Depth: <u>140</u> feet
Rated Pump Capacity: <u>25</u> Gallons Per Minute	Number of Stages: _____

Pump Test Data	Method of Measuring Water Level Circle one
Date Well Tested: <u>9-17-07</u>	Air Line Electric Measuring Line <u>Steel Tube</u>
Static Water Level (A): <u>60</u> Feet Below Land Surface	Other (specify): <u>String Line</u>
Pumping Water Level (B): _____ Feet Below Land Surface	For flowing well, measured static in head: _____ feet
Drawdown (B) - (A): _____ Feet Below Land Surface	Well yielded _____ GPM with a drawdown of _____ feet after _____ hours of pumping
Test Pumping Rate: <u>35.0E</u> Gallons Per Minute	
Duration of Pump Test (minimum 4 hours): _____ hours	

I HEREBY CERTIFY that the above statements are true to the best of my knowledge.  
Travis Boone  
 Print Name of Pump Installer and License No. (if applicable) Signature of Pump Installer

RECEIVED  
 OCT 17 2007  
 BY: OLWR