

APR-20-06 08:58

FROM-LAND & WATER

RECEIVED

601-354-6938

T-544 P.02

F-442

AUG 11 2008

BY: OLWR

Forest

County: WARREN COUNTY
 Permit #: _____
 Driller: JOEY BOYLES
 Date drilling completed: 7-18-08

State Well Report
Part 1 - Driller's Log
 Mississippi Department of Environmental Quality
 Office of Land and Water Resources
 P.O. Box 10631
 Jackson, MS 39289-0631
 (601)961-5210
 (601)354-6938 (fax)

For Office Use Only:
 Aquifer: _____
 Well #: A-98
 L. S. Elevation: _____
 E-log #: _____


State Law requires that this report be prepared by the license holder responsible for the work and filed with the Department at the above address within 30 days of completion of drilling of the well or borehole.

<p>Information on Well Owner <i>(Landowner if borehole is not for a water well)</i></p> <p>Owner Name: <u>CLIFF BURGESS</u> Mailing Address: <u>58 ELIZAY LANE</u> <u>HATTISBURG, MS. 39402</u> City State Zip Code Telephone No. <u>(260) 402-6123</u> <u>Loopmaster Corp. Joe Fish</u></p>	<p>Well or Borehole Location</p> <p>Latitude: <u>31° 25' 31"</u> Longitude: <u>89° 26' 26"</u> Method of Lat/Long (circle one): Conventional Survey, USGS quad, <u>(Hand-held GPS)</u>, Survey-grade GPS <u>NW 1/4 SE 1/4 Sec 6 Twn 5N Rng 14W</u> Distance Direction Nearest Town <u>7 Miles N.W. of HATTISBURG</u></p>
<p>Well / Borehole Data</p> <p>Date drilling started: <u>7-16-08</u> Date drilling completed: <u>7-18-08</u> Hole depth: <u>230 Ft.</u> Hole diameter: <u>4 3/4</u></p> <p>Location of the source of any surface water used for drilling: _____ Method of dosing and volume of Chlorine used in drilling and development: _____</p> <p>Logs run (circle all applicable): No log run Electric Gamma Ray Density Sonic Neutron Other: _____ Name of organization running log(s): _____</p> <p>Purpose of borehole (check one): Water Well _____ Geotechnical/Geological Investigation _____ <u>Ground Source Heat Pump</u> Seismic Survey _____ Other (describe) _____ <i>(If drilling is not related to water well construction, skip the remainder of this block)</i></p> <p>Purpose of Well (check one): Home _____ Industrial _____ Public Supply _____ Irrigation _____ Fish Culture _____ Other: _____</p> <p>If a flowing well, method of flow regulation: Valve _____ Other (describe) _____</p> <p>Static Water Level: _____ feet above or below (circle one) land surface Date measured: _____</p> <p>Method of Measurement (circle one) steel tape electric tape air line other: _____</p> <p>Well depth: _____ Well grouted to a depth of _____ feet Type of grout (circle one): Neat Cement Bentonite Mix Casing length: _____ feet Casing diameter: _____ inches Type of casing: _____ Screen length: _____ feet Screen diameter: _____ inches Type of screen: _____ Screen slot size: _____ inches Setting depth: From _____ feet to _____ feet</p> <p>Type of completion (circle all applicable): Gravel packed Underreamed Telescoped Open hole Natural Development Other (describe): _____</p> <p>Top of lap pipe or reduction in casing: _____ feet <i>If telescoped or more than one screen, describe on next page</i></p>	

A-98

The sketch below only required for water wells.

If well telescopes, show depths on sketch.
Ground Level

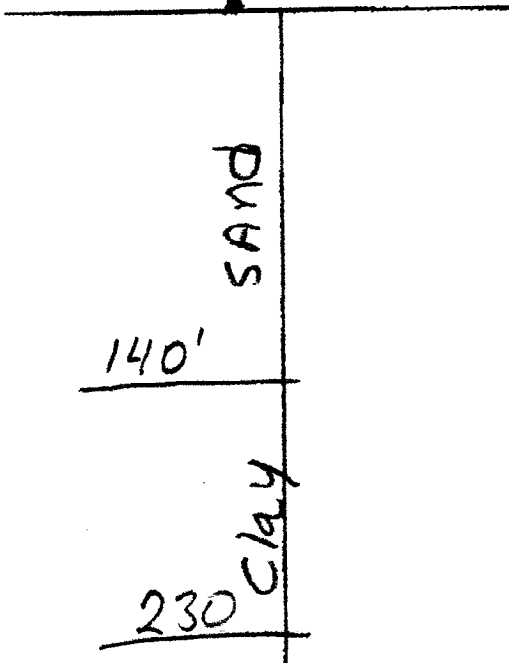

Description of formations encountered must be provided for all wells and boreholes, unless specifically exempted by regulations.

Description of Formations Encountered	From (depth)	To (depth)
	Ground Level	
SAND	0	140
Clay	140	230

If more than one screen, show location of each on sketch

Sketch the property layout and include the following: 1) the well location; 2) any permanent structures on the property that may aid in locating the well; 3) any roads, power lines, or other items that may aid in locating the property and the well; 4) a north arrow.

	A	B
(L-1)	36	34
(L-2)	29	46
(L-3)	18	50
(L-4)	20	40

Landowner Name: _____

Form: OLWR-SWR-1A

I certify that the well/borehole was drilled, constructed, and completed in accordance with all applicable requirements of the Mississippi Department of Environmental Quality and the Mississippi Department of Health regulations, if applicable, and state laws.

By: Fred Danforth 0-698GI 8-2-08

RECEIVED AUG 11 2008

BY: OLWR