

B 25


③

8-24-60

WATER WELL DRILLERS LOG

Date: 8/24, 1960, Driller: DAVID McWILLIAMS County PERRY
(Name)

	Description & Color of Materials Sand, Clay, Red Clay, Shell, etc.	Thick- ness Feet	Depth Feet
(1) Owner of Land: <u>EL LEE</u> <small>(Name)</small> <u>Rt # 5, H. B. MISS</u> <small>(Address)</small>			
(2) Location: <u>SE 1/4, NW 1/4, Sec 13 T5 R3</u> <u>4</u> miles <u>H</u> of <u>PETAL</u> <small>(distance) (direction) (Nearest Town)</small>			
(3) Topography: <u>HILLY</u> <small>(Hilly) (Flat) (Level)</small>			
(4) Purpose of Well: <u>DOMESTIC</u> <small>(Domestic Irrigation Municipal, Industrial, Other)</small>			
Information upon completion of well:			
(1) Diameter <u>4 1/2</u> inches.			
(2) Total Depth <u>122</u> feet.			
(3) Water Level <u>60</u> feet below top of ground.			
(4) Cased to <u>117</u> , Size <u>2 in</u>			
(5) Screen: Size <u>2 in</u> , Length <u>5 ft</u>			
(6) Were any formations sealed against pollution? <u>✓</u> yes, _____ no.			
If YES depth of formation _____			
Why _____			
Drillers Remarks: _____			

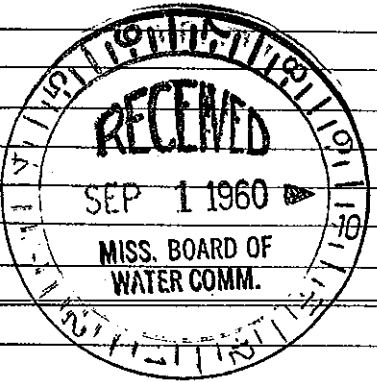

Well No. 5

(Use Back Side)