

Forrest
B 28
11-66

MISSISSIPPI BOARD OF WATER COMMISSIONERS

WATER WELL DRILLERS LOG

Date: 11-30, 1966, Driller: St. P. Drilling Co. County: Forrest
104 Thompson Road, Petal, Miss.


(1) Owner of Land: H. J. Sumrell
 (Name)
Rt. 7, Hattiesburg, Miss.
 (Address)
 (2) Location: NE 1/4, NW 1/4, Sec. 31, T. 13N, R. 13W
 (distance) 1 miles NORTH, of Hattiesburg
 (direction) (Nearest Town)
 (3) Topography: Flat
 (Hilly) (Flat) (Level)
 (4) Purpose of Well: Home
 (Domestic Irrigation, Municipal, Industrial, Other)

Description & Color of Materials Sand, Clay, Red Clay, Shell, etc.	Thick- ness Feet	Depth Feet
<u>Red clay</u>	<u>10</u>	<u>10</u>
<u>Fire sand</u>	<u>10</u>	<u>20</u>
<u>Green</u>	<u>10</u>	<u>30</u>
<u>Blue clay</u>	<u>20</u>	<u>50</u>
<u>Fire sand</u>	<u>5</u>	<u>55</u>
<u>Big sand</u>	<u>15</u>	<u>70</u>

Information upon completion of well:

(1) Diameter 4 1/2 inches.
 (2) Total Depth 70 feet.
 (3) Water Level 16 feet below top of ground.
 (4) Cased to 65 ft, Size 4 in
 (5) Screen: Size 4", Length 5'
 (6) Were any formations sealed against pollution?
 _____ yes, ✓ no.

If YES depth of formation _____
 Why _____
 Drillers Remarks: _____

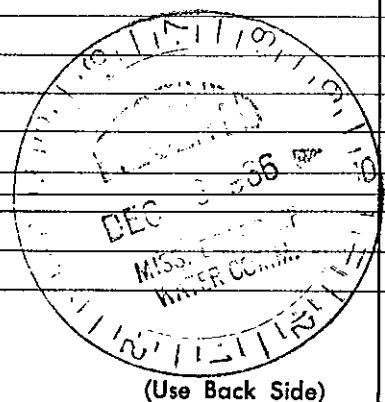

Well No. _____

(Use Back Side)

Mail this copy to Board of Water Commissioners 429 Miss. St. Jackson, Miss