

FORREST MISSISSIPPI BOARD OF WATER COMMISSIONERS

B 29
3-26-66

⑤ WATER WELL DRILLERS' LOG

Date: 3-26, 1966, Driller: S. J. R. Drilling Co. County: Forrest

(1) Owner of Land	Description & Color of Materials Sand, Clay, Red Clay, Shell, etc.	Thick- ness Feet	Depth Feet
Mr. Watson (Name)	Red Sandy Clay	7	7
Glandole, Miss (Address)	White Sand	14	21
(2) Location: 1/4, Sec. 28, T. 5 R. 13, N.W.	White Clay	11	32
one lot Glandole Sub.	Yellow Sand	15	47
1 miles N of Nettie (distance) (direction) (Nearest Town)	White Fine Sand	8	55
(3) Topography: Level (Hilly) (Flat) (Level)	good white sub	13	68
(4) Purpose of Well: Home (Domestic Irrigation Municipal, Industrial, Other)			


Information upon completion of well:

- (1) Diameter 2 inches.
- (2) Total Depth 65 feet.
- (3) Water Level 32 feet below top of ground.
- (4) Cased to 60, Size 2"
- (5) Screen: Size 2", Length 5 ft.
- (6) Were any formations sealed against pollution?
yes, no.

If YES depth of formation _____

Why _____

Drillers Remarks: _____

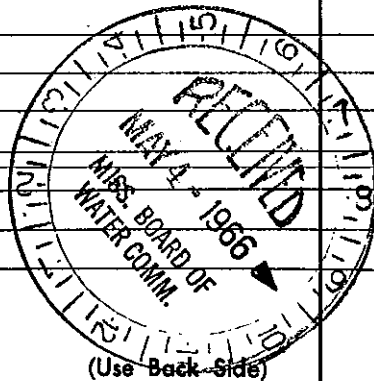

Well No. 112

Mail this copy to Board of Water Commissioners 429 Miss. St. Jackson, Miss