

FORREST MISSISSIPPI BOARD OF WATER COMMISSIONERS

B 31

3-25-66

5

WATER WELL DRILLERS LOG

Date: 3-25, 1966, Driller: Gene S & R Drilling County: Faunt


(Name)

(1) Owner of Land:	Description & Color of Materials Sand, Clay, Red Clay, Shell, etc.	Thick- ness Feet	Depth Feet
(Name) <u>Charles Noble</u>	<u>Red Sandy Clay</u>	<u>12</u>	<u>12</u>
(Address) <u>Glendale Miss</u>	<u>White Sand</u>	<u>11</u>	<u>23</u>
(2) Location: <u>Lot 1</u>	<u>Co. gravel</u>	<u>14</u>	<u>37</u>
1/4, 1/4, Sec. <u>33</u> T <u>5</u> R <u>13</u>	<u>fine white sand</u>	<u>9</u>	<u>46</u>
<u>Glendale Sub. Shopping Center</u>	<u>white sand & gravel</u>	<u>9</u>	<u>55</u>
(distance) <u>2</u> miles (direction) <u>N.</u> of (Nearest Town) <u>Hattiesburg</u>	<u>Stripa Pure Sand & gravel</u>	<u>10</u>	<u>65</u>
(3) Topography: <u>level</u>			
(Hilly) (Flat) (Level)			
(4) Purpose of Well: <u>Industrial</u>			
(Domestic Irrigation Municipal, Industrial, Other)			

Information upon completion of well:

- (1) Diameter 2 inches.
- (2) Total Depth 55 feet.
- (3) Water Level 32 feet below top of ground.
- (4) Cased to 50, Size 2"
- (5) Screen: Size 2", Length 5 ft
- (6) Were any formations sealed against pollution?
 yes, no.

If YES depth of formation _____
 Why _____
 Drillers Remarks: _____

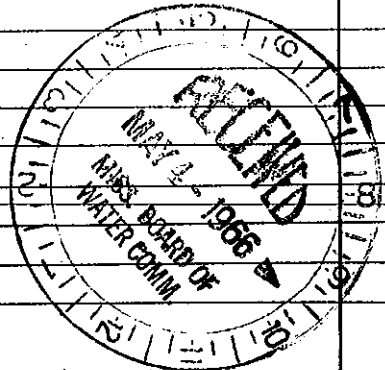

(Use Back Side)

Well No. 1

Mail this copy to Board of Water Commissioners 429 Miss. St. Jackson, Miss.