

Forrest  
B35  
9-66

MISSISSIPPI BOARD OF WATER COMMISSIONERS

(B)

WATER WELL DRILLERS LOG

Date: 9-19, 1966, Driller: S & P Drilling Inc. County Forrest  
104 Champion Blvd, Petal, Miss.  
(Name)

		Description & Color of Materials Sand, Clay, Red Clay, Shell, etc.	Thick- ness Feet	Depth Feet
(1) Owner of Land: <u>C. P. Morgan</u> <small>(Name)</small>		<u>Red Clay</u>	<u>20</u>	<u>20</u>
<u>Rt. 1, Hattiesburg, Miss.</u> <small>(Address)</small>		<u>fine sand</u>	<u>10</u>	<u>30</u>
(2) Location: <u>N 1/4, S W 1/4, Sec. 28, T 8 N, R 12 E</u>		<u>coarse sand</u>	<u>10</u>	<u>40</u>
<u>3</u> miles <u>NORTH-W</u> of <u>Hattiesburg</u>	<small>(distance) (direction) (Nearest Town)</small>	<u>gravel &amp; sand</u>	<u>20</u>	<u>60</u>
(3) Topography: <u>hilly</u> <small>(Hilly) (Flat) (Level)</small>				
(4) Purpose of Well: <u>home</u> <small>(Domestic Irrigation Municipal, Industrial, Other)</small>				

Information upon completion of well:

- (1) Diameter 2 inches.
- (2) Total Depth 79 feet.
- (3) Water Level 69 feet below top of ground.
- (4) Cased to 70, Size 2"
- (5) Screen: Size 2", Length 5 ft
- (6) Were any formations sealed against pollution?  
 yes,  no.

If YES depth of formation \_\_\_\_\_


Why \_\_\_\_\_

Drillers Remarks: \_\_\_\_\_

\_\_\_\_\_

\_\_\_\_\_

\_\_\_\_\_

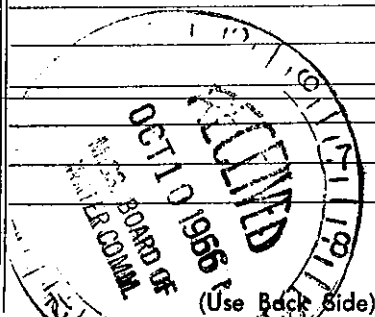

Well No. \_\_\_\_\_