

FORREST MISSISSIPPI BOARD OF WATER COMMISSIONERS

B 36  
3-5-66

③

WATER WELL DRILLERS LOG

Date: 3-5, 1966, Driller: STOR Drilling County: FORREST

Well # 1

(Name)

(1) Owner of Land: David Cox  
(Name)  
Petal, Miss  
(Address)

(2) Location: NW 1/4, SE 1/4, Sec. 6 <sup>NW</sup> 15 R13  
(distance) (direction) (Nearest Town)

6 miles NORTH, of Hattiesburg  
(distance) (direction) (Nearest Town)

(3) Topography: Hilly  
(Hilly) (Flat) (Level)

(4) Purpose of Well: Home  
(Domestic Irrigation, Municipal, Industrial, Other)

Description & Color of Materials Sand, Clay, Red Clay, Shell, etc.	Thick- ness Feet	Depth Feet
<u>Red Sandy Clay</u>	<u>14</u>	<u>14</u>
<u>Red Sand</u>	<u>11</u>	<u>25</u>
<u>Yellow Clay</u>	<u>7</u>	<u>32</u>
<u>Yellow Fine Sand</u>	<u>16</u>	<u>48</u>
<u>White Sand + 9 gravel</u>	<u>8</u>	<u>56</u>
<u>gray clay strip</u>	<u>1/2</u>	<u>56 1/2</u>
<u>fine gravel Sand</u>	<u>14 1/2</u>	<u>71</u>
<u>good white Sand</u>	<u>13</u>	<u>84</u>
<u>pink clay strip</u>	<u>1/2</u>	<u>84 1/2</u>
<u>good white Sand</u>	<u>13 1/2</u>	<u>98</u>

Information upon completion of well:

(1) Diameter 2 inches.

(2) Total Depth 95 feet.

(3) Water Level 79 feet below top of ground.

(4) Cased to 90 ft, Size 2"


(5) Screen: Size 2", Length 5 ft

(6) Were any formations sealed against pollution?  
 yes,  no.

If YES depth of formation \_\_\_\_\_

Why \_\_\_\_\_

Drillers Remarks: \_\_\_\_\_

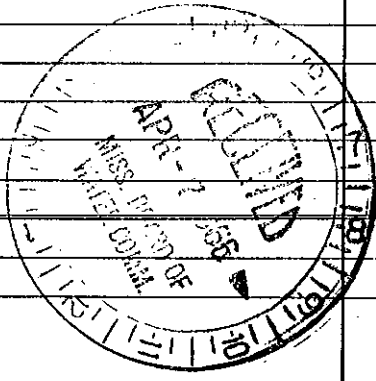

(Use Back Side)

#  
Well No. 1

Mail this copy to Board of Water Commissioners 429 Miss. St. Jackson, Mis: