

FORREST MISSISSIPPI BOARD OF WATER COMMISSIONERS

B 38
3-3-66

③

WATER WELL DRILLERS LOG

S + R Drilling

Date: 3-3, 1966, Driller: HOME County: Forrest

Job # 2

(Name)

(1) Owner of Land:	Description & Color of Materials Sand, Clay, Red Clay, Shell, etc.	Thick- ness Feet	Depth Feet
DAVID COX (Name)	Red Sand Clay	18	18
PETAH, MISS (Address)	Red + white + yellow clay	25	43
(2) Location: NW 1/4, SE 1/4, Sec. 6 T5 R13	Fine W Sand + P gravel	22	65
6 miles NORTH of HATTIESBURG (distance) (direction) (Nearest Town)	Orange Sand	13	78
(3) Topography: HILLY (Hilly) (Flat) (Level)	Fine orange sand	12	90
(4) Purpose of Well: HOME (Domestic Irrigation Municipal, Industrial, Other)	good white sand	12	102


Information upon completion of well:

- (1) Diameter 2 inches.
- (2) Total Depth 100 feet.
- (3) Water Level 68 feet below top of ground.
- (4) Cased to 95, Size 2"
- (5) Screen: Size 2", Length 5 ft
- (6) Were any formations sealed against pollution?
 yes, no.

If YES depth of formation _____

Why _____

Drillers Remarks: _____

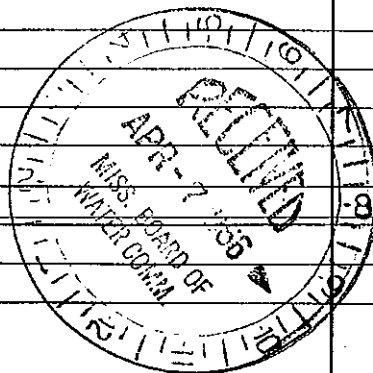

(Use Back Side)

Well No. #3

Mail this copy to Board of Water Commissioners 429 Miss. St. Jackson, Miss: