

FORREST

B 39 ③  
3-6-66

WATER WELL DRILLERS LOG

Date: 3-7-66, 1966, Driller: MENE S+R Drilling Co., County: FORREST

Job # 4

(Name)

(1) Owner of Land: David Cox  
(Name)  
PETAH, Miss  
(Address)

(2) Location: NW 1/4, SE 1/4, Sec. 6 T5 R13  
6 miles NORTH, of Heathsburg  
(distance) (direction) (Nearest Town)

(3) Topography: Hilly  
(Hilly) (Flat) (Level)

(4) Purpose of Well: Home  
(Domestic Irrigation  
Municipal, Industrial, Other)

Description & Color of Materials Sand, Clay, Red Clay, Shell, etc.	Thick- ness Feet	Depth Feet
Red Sandy Clay	12	12
Red Sand	11	23
White & yellow Clay	8	31
White Sand & p gravel	23	54
White Clay	3	57
Fine white sand	14	71
good white sand	13	84
Pink Clay	1	85
good white sand	11	96
orange sand	8	104

Information upon completion of well:

(1) Diameter 2 inches.

(2) Total Depth 95 feet.

(3) Water Level 72 feet below top of ground.

(4) Cased to 90, Size 2"


(5) Screen: Size 2", Length 5 ft.

(6) Were any formations sealed against pollution?  
\_\_\_\_\_ yes,  no.

If YES depth of formation \_\_\_\_\_

Why \_\_\_\_\_

Drillers Remarks: \_\_\_\_\_

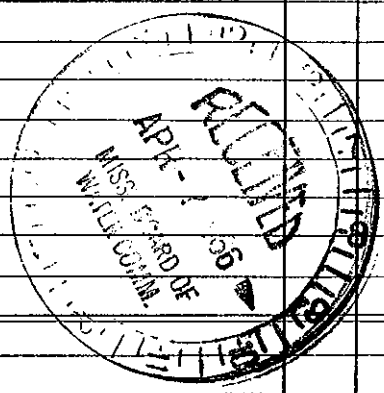

#  
Well No. 1

(Use Back Side)

Mail this copy to Board of Water Commissioners 429 Miss. St. Jackson, Mis: