

FORREST MISSISSIPPI BOARD OF WATER COMMISSIONERS

B44 ⑤
6-3-66

WATER WELL DRILLERS LOG

Date: June 3, 1966 Driller: Timms County: Forrest
(Name)

(1) Owner of Land: <u>Wilmar Smith</u> (Name)	Description & Color of Materials Sand, Clay, Red Clay, Shell, etc.	Thick- ness Feet	Depth Feet
<u>Route 7 - Nbg.</u> (Address)	<u>red clay</u>	<u>0</u>	<u>40</u>
(2) Location: <u>1/4, 1/4, Sec. 8 T5 R13</u> <u>4 miles north of Nbg.</u> (distance) (direction) (Nearest Town)	<u>sand</u>	<u>40</u>	<u>112</u>
(3) Topography: <input checked="" type="checkbox"/> (Hilly) <input type="checkbox"/> (Flat) <input type="checkbox"/> (Level)			
(4) Purpose of Well: <u>Domestic</u> (Domestic Irrigation Municipal, Industrial, Other)			


Information upon completion of well:

- (1) Diameter 2" inches.
- (2) Total Depth 112 feet.
- (3) Water Level 60 feet below top of ground.
- (4) Cased to 107, Size 2"
- (5) Screen: Size 2", Length 5 ft.
- (6) Were any formations sealed against pollution?
no.

If YES depth of formation _____

Why _____

Drillers Remarks: _____

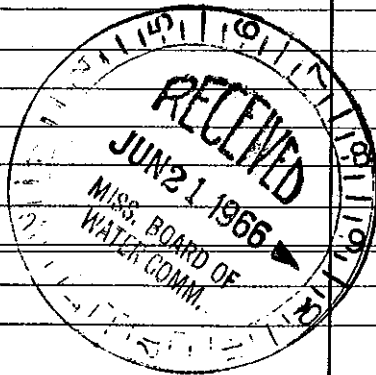

Well No.

(Use Back Side)

Mail this copy to Board of Water Commissioners 429 Miss. St. Jackson, Miss.