

FORREST MISSISSIPPI BOARD OF WATER COMMISSIONERS


B 46 (6)
5-6-65

WATER WELL DRILLERS LOG

Date: 5-6-1965, Driller: Jay Lath County: Forrest

Hattiesburg (Name) Britton Gas

(1) Owner of Land: <u>Sam Jones</u> (Name)	Description & Color of Materials Sand, Clay, Red Clay, Shell, etc.	Thick- ness Feet	Depth Feet
<u>Route Hattiesburg Miss</u> (Address)	0-5 ye		
(2) Location: <u>1/4, 1/4, Sec. 5 T. 136 R.</u>	5-11 WS		
<u>6</u> miles <u>N</u> , of <u>H'burg</u> (distance) (direction) (Nearest Town)	11-15 WC		
(3) Topography: <u>Flat</u> (Hilly) (Flat) (Level)	15-102 ye		
(4) Purpose of Well: <u>Domestic</u> (Domestic Irrigation Municipal, Industrial, Other)	102-120 WS		
Information upon completion of well:			
(1) Diameter _____ inches.			
(2) Total Depth _____ feet.			
(3) Water Level _____ feet below top of ground.			
(4) Cased to _____, Size _____.			
(5) Screen: Size _____, Length _____.			
(6) Were any formations sealed against pollution?			
_____ yes, _____ no.			
If YES depth of formation _____			
Why _____			
Drillers Remarks: _____			

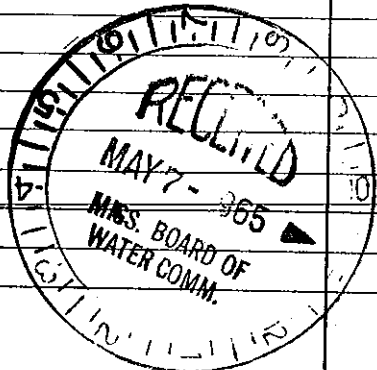

(Use Back Side)

Well No.

Mail this copy to Board of Water Commissioners 429 Miss. St. Jackson, Miss.