

FORREST MISSISSIPPI BOARD OF WATER COMMISSIONERS

B 48 ②
2-22-62


WATER WELL DRILLERS LOG

Date: 2-22, 1962, Driller: HERMAN PARKER County FORREST
(Name)

(1) Owner of Land: <u>C.S. Bennett</u> (Name)	Description & Color of Materials Sand, Clay, Red Clay, Shell, etc.	Thick- ness Feet	Depth Feet
<u>Rt. 7 - HATTIESBURG, MISS</u> (Address)	<u>Blue clay</u> <u>sand</u>	<u>120</u> <u>55</u>	<u>120</u> <u>175</u>
(2) Location: <u>1/4</u> , <u>1/4</u> , Sec. <u>25</u> T <u>5</u> N R <u>13</u> W			
<u>2 1/2</u> miles <u>North</u> , of <u>HATTIESBURG</u> (distance) (direction) (Nearest Town)			
(3) Topography: <u>Hilly</u> (Hilly) (Flat) (Level)			
(4) Purpose of Well: <u>Domestic</u> (Domestic Irrigation Municipal, Industrial, Other)			

Information upon completion of well:

- (1) Diameter 2 inches.
- (2) Total Depth 175 feet.
- (3) Water Level 38 feet below top of ground.
- (4) Cased to 175, Size 2"
- (5) Screen: Size 2", Length 5'
- (6) Were any formations sealed against pollution?
no yes, no no.
- If YES depth of formation _____
- Why _____
- Drillers Remarks: _____

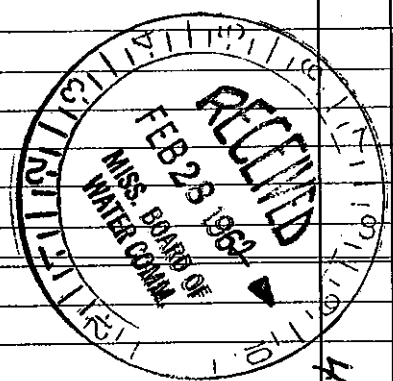

Well No. 43

(Use Back Side)

Mail this copy to Board of Water Commissioners 429 Miss. St. Jackson, Miss