

MISSISSIPPI BOARD OF WATER COMMISSIONERS

FORREST
B 49
5-6-61

⑥ WATER WELL DRILLERS LOG

B-301

Date: 5-6, 1961, Driller: HERMON PARKER County: FORREST
(Name)

	Description & Color of Materials Sand, Clay, Red Clay, Shell, etc.	Thick- ness Feet	Depth Feet
(1) Owner of Land: <u>ROEN BAI</u> (Name) <u>Petal, Miss.</u> (Address)	Red Clay		
(2) Location: <u>1/4</u> , <u>1/4</u> , Sec. <u>12</u> <u>T. 15 N.</u> <u>R. 3 E.</u> <u>3</u> miles <u>NORTH</u> , of <u>H. BURL.</u> (distance) (direction) (Nearest Town)	<u>RED CLAY</u> <u>SAND</u> <u>GRAVEL</u> <u>SAND</u>	<u>17</u> <u>17</u> <u>34</u> <u>40</u>	<u>17</u> <u>34</u> <u>40</u> <u>45</u>
(3) Topography: <u>FLAT</u> (Hilly) (Flat) (Level)			
(4) Purpose of Well: <u>domestic</u> (Domestic Irrigation Municipal, Industrial, Other)			


Information upon completion of well:

- (1) Diameter 2 inches.
- (2) Total Depth 45 feet.
- (3) Water Level 31' feet below top of ground.
- (4) Cased to 45', Size 2"
- (5) Screen: Size 2", Length 4'
- (6) Were any formations sealed against pollution?
no.

If YES depth of formation _____

Why _____

Drillers Remarks: _____

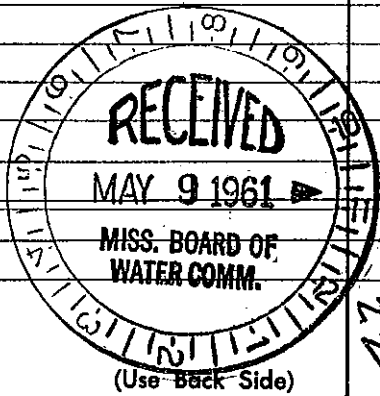

Well No. 22

Mail this copy to Board of Water Commissioners 429 Miss. St. Jackson, Miss