

FORREST
B 52
2-68

MISSISSIPPI
BOARD OF WATER COMMISSIONERS
416 North State Street
Jackson, Mississippi 39201

WATER WELL DRILLERS LOG

Feb 1 1968 *B&R* *Faunt*
date well completed firm name county well located

LANDOWNER: *C. F. Williams*

description of formations encountered

from to

pt 7
Hattiesburg, Miss
(mpt/lat/address)

Clay Red
Summit
Clay White
St. Louis & Peabody
Course 12RS

0 10
10 30
30 35
35 50
50 65

WELL LOCATION:


sec. *29* T. *5* N. R. *15* E
S W
4 miles *NO* of *Hattiesburg*
(distance) (direction) (nearest town)

WELL PURPOSE:

(home, irrigation, municipal, industrial) *Home*

WELL COMPLETION DATA:

- (1) diameter (inches) *2"*
- (2) total depth (feet) *65*
- (3) static water level (feet) *23* below above top of ground.
- (4) casing *PVC* *60*
(material) (depth)
2" if telescope see back.
(size)
- (5) screen *5 ft* *60 ft*
(length) (depth to top)
2" *PVC*
(size) (material)
- (6) pump *1/2* *700 gpm*
(HP) (yield gpm)
Electric
(type power)
- (7) electric log *no*
(yes or no)
(organization running log)
- (8) how well bottom plugged *valve*

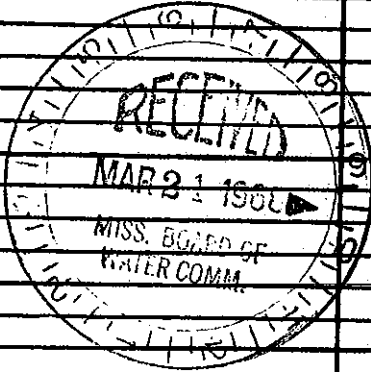

DRILLERS REMARKS: