


Forrest
B 124
9/8/80
Sept 8
 date well completed

CODEU

MISSISSIPPI
 BOARD OF WATER COMMISSIONERS
 416 North State Street
 Jackson, Mississippi 39201

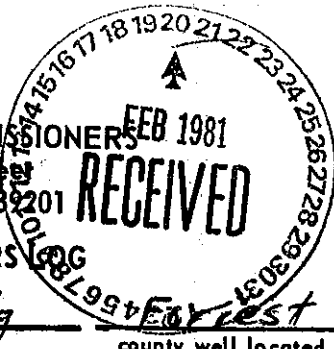

WATER WELL DRILLERS LOG

Roy West Drig
 firm name
Forrest
 county well located

LANDOWNER:	description of formations encountered	from	to
<u>WARREN PAVING CO.</u>		<u>CLAY</u>	<u>0</u>
<u>Hattiesburg MS</u> (mailing address)	<u>GRAVEL</u>	<u>3</u>	<u>20</u>
WELL LOCATION:	<u>SAND</u>	<u>20</u>	<u>40</u>
sec <u>10</u> T <u>S</u> R <u>13</u> E	<u>CLAY</u>	<u>40</u>	<u>50</u>
<u>7 1/2</u> miles <u>NW</u> of <u>Petal</u>	<u>SAND</u>	<u>50</u>	<u>63</u>
(distance) (direction) (nearest town)			
WELL PURPOSE: <u>HOME</u>	<u>WATER IN</u>		
(home, irrigation, municipal, industrial)	<u>50-63 SAND</u>		
WELL COMPLETION DATA:	<u>SALTY</u>		
(1) diameter (inches) <u>4"</u>			
(2) total depth (feet) <u>63'</u>			
(3) static water level (feet) <u>15'</u> below/above top of ground.			
(4) casing <u>PVC</u> <u>53'</u> (material) (depth)			
(size) if telescope see back.			
(5) screen <u>10</u> <u>53'</u> (length) (depth to top)			
<u>2"</u> <u>PVC</u> (size) (material)			
(6) pump <u>well plugged</u> (HP) (yield gpm)			
(type power)			
(7) electric log <u>no</u> (yes or no)			
(organization running log)			
(8) how well bottom plugged <u>WASH W/ALUM</u>			
DRILLERS REMARKS:			

DEPT. OF NATURAL RESOURCES
 BUREAU OF LAND & WATER RESOURCES

FEB 20 1981

RECEIVED