


FORREST
 B 7007
 9-9-80
 Sept 9
 date well completed

MISSISSIPPI
 BOARD OF WATER COMMISSIONERS
 416 North State Street
 Jackson, Mississippi 39201

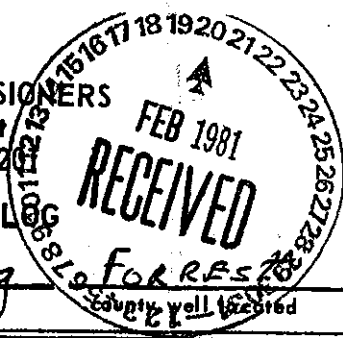

WATER WELL DRILLERS LOG
 1980 Roy V. West Drig
 firm name

LANDOWNER:	description of formations encountered	from	to
(mailing address)			
WARREN PAVING CO	CLAY	0	3
	GRAVEL	3	20
	SAND	20	40
WELL LOCATION: sec. 10 T <u>SN</u> R. 13 E S W 7.75 miles NW of Petal (distance) (direction) (nearest town)			
WELL PURPOSE: (home, irrigation, municipal, industrial)			
WELL COMPLETION DATA: (1) diameter (inches) <u>4"</u> (2) total depth (feet) <u>40'</u> (3) static water level (feet) <u>15'</u> below above top of ground. (4) casing <u>PVC</u> <u>30'</u> (material) (depth) (size) if telescope see back. (5) screen <u>10'</u> <u>30'</u> (length) (depth to top) <u>2"</u> <u>PVC</u> (size) (material) (6) pump <u>1/2</u> <u>15</u> (HP) (yield gpm) <u>REA</u> (type power) (7) electric log <u>NO</u> (yes or no) (organization running log) (8) how well bottom plugged <u>WASH VALVE</u>			
DRILLERS REMARKS: FEB 20 1981 RECEIVED			

DEPT. OF NATURAL RESOURCES
 BUREAU OF LAND & WATER RESOURCES