

FORREST MISSISSIPPI BOARD OF WATER COMMISSIONERS


C 8 ③

4-20-66

WATER WELL DRILLERS LOG

Date: 4-20, 1966, Driller: S. R. Drilling County: Forrest  
(Name)

(1) Owner of Land:	Description & Color of Materials Sand, Clay, Red Clay, Shell, etc.	Thick- ness Feet	Depth Feet
<u>L. R. Mason</u> <small>(Name)</small> <u>Rt 5, Hattiesburg, Miss</u> <small>(Address)</small>	<u>Red Clay</u>	<u>14</u>	<u>14</u>
<u>SW COR SE 1/4, SE 1/4, Sec. 20 T. 5. R. 12</u> <small>(Location)</small>	<u>White Sand</u>	<u>13</u>	<u>27</u>
<u>4</u> miles <u>NE</u> of <u>Petal</u> <small>(distance) (direction) (Nearest Town)</small>	<u>Red Clay</u>	<u>14</u>	<u>41</u>
<u>Hilly</u> <small>(Topography)</small>	<u>Fine White Sand</u>	<u>20</u>	<u>61</u>
<u>Home</u> <small>(Purpose of Well)</small>	<u>White Clay</u>	<u>1</u>	<u>62</u>
<u>Information upon completion of well:</u>	<u>Fine Brown Sand</u>	<u>17</u>	<u>79</u>
(1) Diameter <u>4</u> inches.	<u>Good White Sand</u>	<u>9</u>	<u>88</u>
(2) Total Depth <u>88</u> feet.	(3) Water Level <u>65</u> feet below top of ground.	(4) Cased to <u>83</u> , Size <u>4"</u>	(5) Screen: Size <u>4"</u> , Length <u>5 ft.</u>
(6) Were any formations sealed against pollution? <u>no</u>	If YES depth of formation _____	Why _____	Drillers Remarks: _____

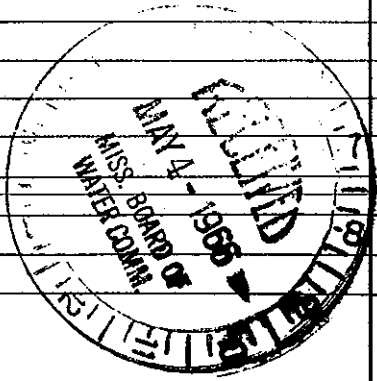

(Use Back Side)

Well No. 108

Mail this copy to Board of Water Commissioners 429 Miss. St. Jackson, Miss.