

FORREST MISSISSIPPI BOARD OF WATER COMMISSIONERS

C10 ③

WATER WELL DRILLERS LOG

8-25-60

10
301

Date: Aug 25 1960 Driller: TIMS County: FORREST
(Name)

(1) Owner of Land: <u>RC. GATTIN</u> (Name)	Description & Color of Materials Sand, Clay, Red Clay, Shell, etc.	Thick- ness Feet	Depth Feet
<u>RT. 5 HATTIESBURG</u> (Address)			
(2) Location: <u>NE 1/4, SW 1/4, Sec. 17 T5 R12 W</u> <u>8</u> miles <u>NE</u> of <u>HATT</u> (distance) (direction) (Nearest Town)			
(3) Topography: <u>HILL</u> (Hilly) (Flat) (Level)			
(4) Purpose of Well: <u>HOME</u> (Domestic Irrigation Municipal, Industrial, Other)			


Information upon completion of well:

- (1) Diameter 2 inches.
- (2) Total Depth 112 feet.
- (3) Water Level 19 feet below top of ground.
- (4) Cased to WPA, Size 2"
- (5) Screen: Size 2" , Length 17 1/2
- (6) Were any formations sealed against pollution?
_____ yes, no.

If YES depth of formation _____

Why _____

Drillers Remarks: _____

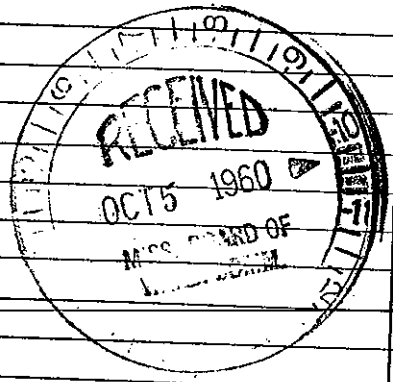

(Use Back Side)

Well No. 10