

Forrest  
C 13  
9-66

MISSISSIPPI BOARD OF WATER COMMISSIONERS

③

WATER WELL DRILLERS LOG

Date: 9-5, 1966, Driller: H R Drilling Co, Bunty Forrest  
104 Thompson Blvd. (Name) Petal Miss

(1) Owner of Land: C. E. Pullerch  
(Name)  
R. F. D. 1 Hattiesburg Miss  
(Address)

(2) Location: NE 1/4 S W 1/4, Sec. 11 T54R12E  
7 miles West of Hattiesburg, Miss  
(Distance) (direction) (Nearest Town)

(3) Topography: Hilly  
(Hilly) (Flat) (Level)

(4) Purpose of Well: Farm  
(Domestic Irrigation  
Municipal, Industrial, Other)

Description & Color of Materials Sand, Clay, Red Clay, Shell, etc.	Thick- ness Feet	Depth Feet
Sand & gravel	20	20
Red clay shale	10	30
White clay	5	35
Thin sand	5	40
Thin sand	10	50


Information upon completion of well:

- (1) Diameter 4 inches.
- (2) Total Depth 50 feet.
- (3) Water Level 34 feet below top of ground.
- (4) Cased to 47 ft, Size 4"
- (5) Screen: Size 4", Length 5 ft.
- (6) Were any formations sealed against pollution?  
yes,  no.

If YES depth of formation \_\_\_\_\_

Why \_\_\_\_\_

Drillers Remarks: \_\_\_\_\_

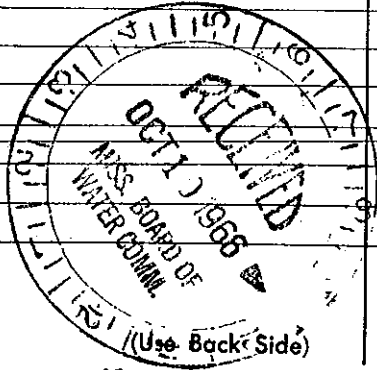

Well No. \_\_\_\_\_

This copy to Board of Water Commissioners 429 Miss. St. Jackson, Miss.