

MISSISSIPPI BOARD OF WATER COMMISSIONERS

FORREST

C 16

⑥

WATER WELL DRILLERS LOG

Date: 11-21, 1962, Driller: W. N. Moore County Forrest
Lee Home BLDG. CO. (Name)

(1) Owner of Land:	Description & Color of Materials Sand, Clay, Red Clay, Shell, etc.	Thick- ness Feet	Depth Feet
<u>Smith</u> (Name)	<u>Surveil</u> 0	10	10
<u>PT 2 Hattiesburg</u> (Address)	<u>Clay Sand Shale</u> 10	60	50
(2) Location: <u>1/4, 1/4, Sec. 34 T 5N R 12W</u>	60	68	8
<u>BETWEEN Hattiesburg & Dumbarton</u> miles			
_____ miles, of _____ (distance) (direction) (Nearest Town)			
(3) Topography: <u>✓</u> (Hilly) (Flat) (Level)			
(4) Purpose of Well: <u>DRINKING</u> (Domestic Irrigation Municipal, Industrial, Other)			

Information upon completion of well:

- (1) Diameter 2" inches.
- (2) Total Depth 68 feet.
- (3) Water Level 43. feet below top of ground.
- (4) Cased to 62., Size 3"
- (5) Screen: Size 2., Length 6
BORTO
- (6) Were any formations sealed against pollution?
 yes, no.


If YES depth of formation _____

Why _____

Drillers Remarks: This Well Was Made

For Lee Home BLDG. CO.

Contract. B.S.

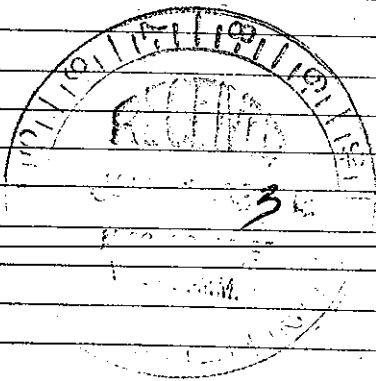

(Use Back Side)

Well No. 4