

FORREST

MISSISSIPPI BOARD OF WATER COMMISSIONERS

C 18 ⑥  
11-23-64

WATER WELL DRILLERS LOG

Date: 11/23, 1964, Driller: Jay Galt County Forrest

Hattiesburg Lutane

(1) Owner of Land: Ray Carter  
(Name)

Rt 2, Hattiesburg  
(Address)

(2) Location: 1/4, 1/4, Sec. 32 T5 R12W

1 1/2 miles East, of Sunvicom  
(distance) (direction) (Nearest Town)

(3) Topography: Hilly  
(Hilly) (Flat) (Level)

(4) Purpose of Well: Domestic  
(Domestic Irrigation  
Municipal, Industrial, Other)

Description & Color of Materials  
Sand, Clay, Red Clay, Shell, etc.

Thick-  
ness  
Feet

Depth  
Feet

0-15 RC  
15-25 RS  
25-34 WS

Information upon completion of well:

(1) Diameter 2 inches.

(2) Total Depth 34 feet.

(3) Water Level 20 feet below top of ground.

(4) Cased to \_\_\_\_\_, Size \_\_\_\_\_

(5) Screen: Size 2", Length 5 ft.


(6) Were any formations sealed against pollution?

\_\_\_\_\_ yes, \_\_\_\_\_ no.

If YES depth of formation \_\_\_\_\_

Why \_\_\_\_\_

Drillers Remarks: \_\_\_\_\_

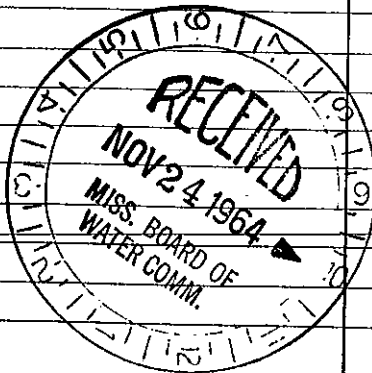

(Use Back Side)

Well No.

Mail this copy to Board of Water Commissioners 429 Miss. St. Jackson, Miss.