

FORREST MISSISSIPPI BOARD OF WATER COMMISSIONERS

C 19

3-19-66

⑥

S + R. Drilling
WATER WELL DRILLERS LOG



Date: 3/19, 1966, Driller: Gene County Forrest
(Name)

(1) Owner of Land: <u>Walter Clinton</u> (Name)	Description & Color of Materials Sand, Clay, Red Clay, Shell, etc.	Thick- ness Feet	Depth Feet
<u>Ortal, Miss</u> (Address)	Red Clay	12	12
(2) Location: $\frac{1}{4}$, $\frac{1}{4}$, Sec. <u>2</u> T <u>5N</u> R <u>12W</u>	Fine White Sand	5	17
<u>7</u> miles <u>NE</u> , of <u>Hattiesburg</u> (distance) (direction) (Nearest Town)	White Clay	1	18
(3) Topography: <u>Level</u> (Hilly) (Flat) (Level)	White Sand	10	28
(4) Purpose of Well: <u>Home</u> (Domestic Irrigation Municipal, Industrial, Other)	Blue Clay	32	60


Information upon completion of well:

- (1) Diameter 2 inches.
- (2) Total Depth 28 feet.
- (3) Water Level 18 feet below top of ground.
- (4) Cased to 23, Size 2"
- (5) Screen: Size 2", Length 5 ft.
- (6) Were any formations sealed against pollution?
_____ yes, no.

If YES depth of formation _____

Why _____

Drillers Remarks: _____

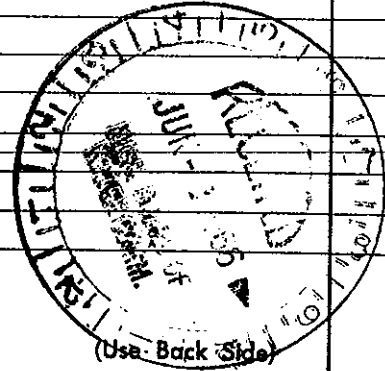

(Use Back Side)

Well No. 9