

FORREST MISSISSIPPI BOARD OF WATER COMMISSIONERS

C 70 ③  
5-2-66

S & R Drilling  
WATER WELL DRILLERS LOG


Date: 5-2, 1966, Driller: Gene County Forrest  
(Name)

|   |            | Description & Color of Materials<br>Sand, Clay, Red Clay, Shell, etc. | Thick-<br>ness<br>Feet | Depth<br>Feet |
|---|------------|---|------------------------|---------------|
| (1) Owner of Land: <u>Jimmy Nutwood</u><br>(Name)   |            | <u>Red Clay</u>   | <u>18</u>              | <u>18</u>     |
| <u>Rt 5 Hattiesburg Miss</u><br>(Address)   |            | <u>White Sand</u>   | <u>9</u>               | <u>27</u>     |
| (2) Location: <u>SE 1/4, SW 1/4, Sec. 20 T5R12</u><br><u>SE 1/4</u>                       | <u>N W</u> | <u>Bank Clay</u>  | <u>16</u>              | <u>43</u>     |
| <u>4</u> miles <u>NE</u> , of <u>Petal</u><br>(distance) (direction) (Nearest Town)       |            | <u>White Sand</u>   | <u>5</u>               | <u>48</u>     |
| (3) Topography: <u>Hilly</u><br>(Hilly) (Flat) (Level)                                    |            | <u>Brown Clay</u>   | <u>7</u>               | <u>55</u>     |
| (4) Purpose of Well: <u>Home</u><br>(Domestic Irrigation<br>Municipal, Industrial, Other) |            | <u>Fine White Sand</u>  | <u>21</u>              | <u>76</u>     |
|   |            | <u>good White Sand</u>  | <u>9</u>               | <u>85</u>     |

Information upon completion of well:

- (1) Diameter 2 inches.
- (2) Total Depth 85 feet.
- (3) Water Level 62 feet below top of ground.
- (4) Cased to 80 ft, Size 2"
- (5) Screen: Size 2", Length 5 ft
- (6) Were any formations sealed against pollution?  
yes, no.

If YES depth of formation \_\_\_\_\_  
Why \_\_\_\_\_  
Drillers Remarks: \_\_\_\_\_

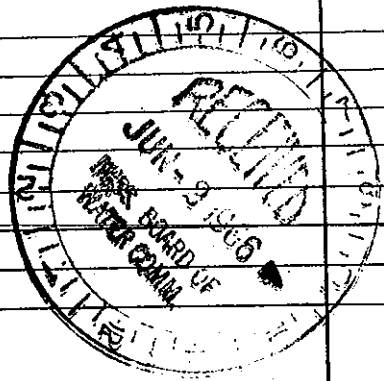

(Use Back Side)

Well No. 8

Mail this copy to Board of Water Commissioners 429 Miss. St. Jackson, Miss.