

Forest
C 21
8-68

MISSISSIPPI
 BOARD OF WATER COMMISSIONERS
 416 North State Street
 Jackson, Mississippi 39201

CODED

WATER WELL DRILLERS LOG

Aug 10, 1968 Tina Drilling Serv Forest
 date well completed firm name county well located


LANDOWNER: W. Byrd
Natickbury Miss
Road 5
 (mailing address)

description of formations encountered	from	to
	<u>Red Clay</u>	<u>0</u>
<u>Clay Sand</u>	<u>8</u>	<u>22</u>
<u>Sand</u>	<u>22</u>	<u>34</u>
<u>Gravel</u>	<u>34</u>	<u>50</u>
<u>Sand</u>	<u>50</u>	<u>78</u>

WELL LOCATION:
 sec. 10 T. 5 N R. 12 E
7 miles N-E of pelad
 (distance) (direction) (nearest town)

WELL PURPOSE: Home
 (home, irrigation, municipal, industrial)

- WELL COMPLETION DATA:
- diameter (inches) 4 in
 - total depth (feet) 78
 - static water level (feet) 50 below above top of ground.
 - casing PVC 73
 (material) (depth)
 (size) If telescope see back.
 - screen 5 73
 (length) (depth to top)
4 plastic
 (size) (material)
 - pump 1 9
 (HP) (yield gpm)
Sk.
 (type power)
 - electric log No
 (yes or no)
 (organization running log)
 - how well bottom plugged Value

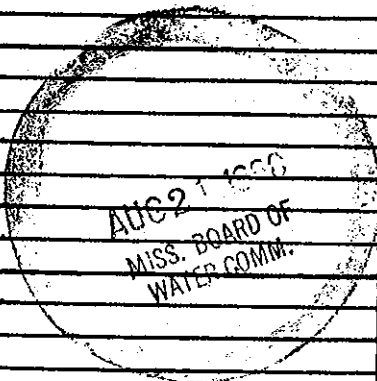

DRILLERS REMARKS:
Good Well