

FORREST MISSISSIPPI BOARD OF WATER COMMISSIONERS

DC 43

9-2-64

WATER WELL DRILLERS LOG

CODED

Date: 9-2, 1964, Driller: W. H. Moore County Forrest

(Name)

(1) Owner of Land:	Description & Color of Materials Sand, Clay, Red Clay, Shell, etc.	Thick- ness Feet	Depth Feet
<u>Miss THOMPSON</u> (Name)	<u>Surface</u> 0	12	
<u>Wattsburg Miss</u> (Address)	<u>Red Grn</u> 18	24	
(2) Location: <u>1/4</u> , <u>1/4</u> , Sec. <u>24</u> T. <u>5</u> R. <u>12</u>	<u>Gumbo &amp; Clay Pellets</u> 24	40	
_____ miles _____ of <u>Purnell Station</u> (distance) (direction) (Nearest Town)	<u>Sand + Gravel</u> 40	61	
(3) Topography: <input checked="" type="checkbox"/> (Hilly) <input type="checkbox"/> (Flat) <input type="checkbox"/> (Level)			
(4) Purpose of Well: <u>House</u> (Domestic Irrigation, Municipal, Industrial, Other)			

Plastic  
Information upon completion of well:

- (1) Diameter 2" inches.
- (2) Total Depth 61 feet.
- (3) Water Level 40 feet below top of ground.
- (4) Cased to 56, Size 2"
- (5) Screen: Size 2", Length 5
- (6) Were any formations sealed against pollution?  
\_\_\_\_\_ yes, \_\_\_\_\_ no.

If YES depth of formation \_\_\_\_\_

Why \_\_\_\_\_



Drillers Remarks: 2" Plastic

out side + inside

Let set at 52"

Pump + Clean 2 hrs.

CODED

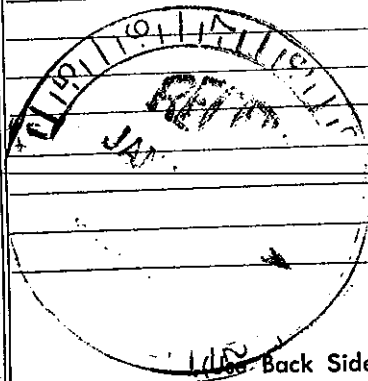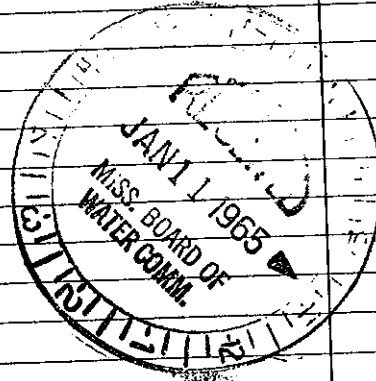

Well No. 37

Mail this copy to Board of Water Commissioners 429 Miss. St. Jackson, Miss