

If well telescopes, please sketch below and show depths:

C-109


Ground level	
8" LAP	498'
12" CASING	580'
8" SCREEN	590'
8" SCREEN	610'
8" SS BLANK	610'
8" SS BLANK	650'
8" SCREEN	650'
8" SCREEN	710'


Description of Formations Encountered	From	To
TOP SOIL	0	2
RED SANDY CLAY	2	15
SAND	15	30
CLAY	30	40
WHITE SANDY CLAY	40	110
SAND	110	208
CLAY	208	240
SAND	240	270
CLAY	270	390
SAND & CLAY STREAKS	390	485
CLAY	485	540
SAND & CLAY STREAKS	540	810
CLAY & SAND STREAKS	810	985
SANDY CLAY	985	1045
CLAY	1045	1135
SANDY CLAY	1135	1317

If more than one screen, show location of each on sketch.

Sketch the property layout and include the following: 1) the well location; 2) any permanent structures on the property that may aid in locating the well; 3) any roads, power lines, or other items that may aid in locating the property and the well; 4) indicate direction.

NORTH



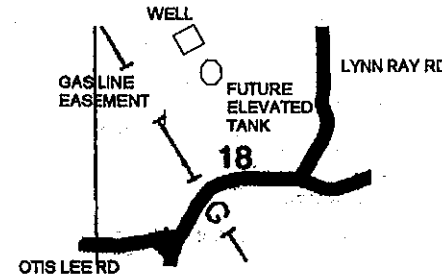

NOT TO SCALE

Landowner's Name: EASTABUCHIE UTILITY ASSOCIATION

LAYNE-CENTRAL

By: *Dave Loh*
 Signature of Water Well Contractor