

Forrest  
 C 2007  
 4-20-81

MISSISSIPPI DEPARTMENT OF NATURAL RESOURCES  
 Bureau of Land and Water Resources  
 Southport Mall  
 P.O. Box 10631  
 Jackson, Mississippi 39209  
 WATER WELL DRILLERS LOG

April 20 1981 Cochran Brothers Drilling Service Forrest  
 date well completed firm name county well located


LANDOWNER:  
 B.M. Knight  
 Rt 8 Nattiesburg  
 (mailing address)

WELL LOCATION:  
 sec. 9 T. 5N S. R. 12 E W  
 2 miles S of Morriston  
 (distance) (direction) (nearest town)

WELL PURPOSE:  
 (home, irrigation, municipal, industrial)

WELL COMPLETION DATA:  
 (1) diameter (inches) 2"  
 (2) total depth (feet) 80'  
 (3) static water level (feet) 48' below top of ground.  
 (4) casing PUC, 75' (material), (depth), (size) if telescope see back.  
 (5) screen 5', 75' (length), (depth to top), 2" PUC (size), (material)  
 (6) pump 1 (HP), 6 (yield gpm), Elect. (type power)  
 (7) electric log no (yes or no)  
 (organization running log)  
 (8) how well bottom plugged valve

description of formations encountered	from	to
Top soil	0	1
Red clay	1	8
Red sand	8	14
white clay	14	19
gray clay	19	28
Blue clay	28	51
sand	51	80

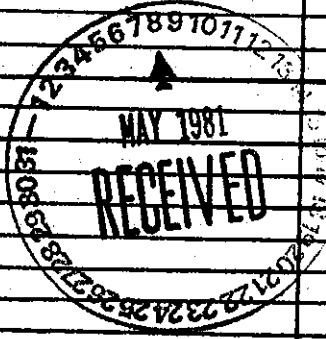

DRILLERS REMARKS: