

FORREST

MISSISSIPPI BOARD OF WATER COMMISSIONERS

D 51 ③
9-29-60

USGS File

WATER WELL DRILLERS LOG

✓ D 304

Date: 9/29, 1960, Driller: Kimms County: Forrest
(Name)

(1) Owner of Land:	Description & Color of Materials Sand, Clay, Red Clay, Shell, etc.	Thick- ness Feet	Depth Feet
<u>W. D. Carpenter</u> (Name) <u>Box 2 (Carterville)</u> (Address)	<u>0-4 Clay</u> <u>4-35 Sand + P. gravel</u>		
(2) Location: <u>SE 1/4, NE 1/4, Sec. 12 T. 4 R. 13</u> <u>1/4 miles West of Carterville</u> (distance) (direction) (Nearest Town)			
(3) Topography: <u>level</u> (Hilly) (Flat) (Level)			
(4) Purpose of Well: <u>Home</u> (Domestic Irrigation Municipal, Industrial, Other)			


Information upon completion of well:

- (1) Diameter 2 inches.
- (2) Total Depth 35 feet.
- (3) Water Level 18 feet below top of ground.
- (4) Cased to 3/4, Size 2"
- (5) Screen: Size 2", Length 4 ft.
- (6) Were any formations sealed against pollution?
_____ yes, no.

If YES depth of formation _____

Why _____

Drillers Remarks: _____

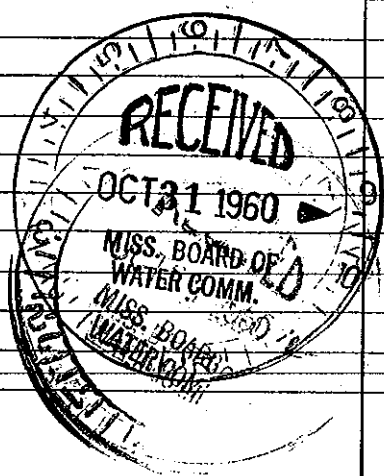

(Use Back Side)

W.D.

Mail this copy to Board of Water Commissioners 429 Miss. St. Jackson, Miss.