

TO BE PLUGGED
6/96

3

Forrest
D 60
3-67

MISSISSIPPI
BOARD OF WATER COMMISSIONERS
416 North State Street
Jackson, Mississippi 39201

WATER WELL DRILLERS LOG

3-24 1967 Super-Central Co. Forrest
date well completed firm name county well located

LANDOWNER: Hercules, Inc.

description of formations encountered	from	to
Clay and Gravel Fill	0	5
Soft Clay and Sand	5	18
Hard White Clay	18	120
Hard Shale	120	140
Gummy Clay	140	220
Clay and Sand streak	220	242
Sand & Shale Clay	242	264
Sand	264	290
Clay and Sand streak	290	337
Sand coarse	337	533
Clay	533	555
Sand & Shale Clay	555	567
Sand	567	600
Sand and Shale	600	617
Sand	617	677
Sand and Shale Shale	677	689


Hattiesburg, Miss
(mailing address)

WELL LOCATION:
sec. 4 T. 4 N R. 13 E
S W
miles in of Hattiesburg
(distance) (direction) (nearest town)

WELL PURPOSE: Industrial
(home, irrigation, municipal, industrial)

WELL COMPLETION DATA:

- (1) diameter (inches) 18"
- (2) total depth (feet) 671'
- (3) static water level (feet) 26' below above top of ground.
- (4) casing (material) 570' (depth)
18" (size) if telescope see back.
- (5) screen 70' 575' (length) (depth to top)
10" (size) Stainless steel (material)
- (6) pump 125 (HP) (yield gpm)
Electric (type power)
- (7) electric log NO (yes or no)
(organization running log)
- (8) how well bottom plugged

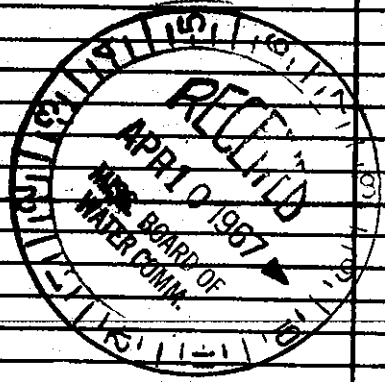

DRILLERS REMARKS:

Pump not installed as of this date.