

BOARD OF WATER COMMISSIONERS

FORREST

D 62


⑥ WATER WELL DRILLERS LOG

10-6-62

Date: 10-6, 1962, Driller: Herman Parker County, Forrest

(Name)

(1) Owner of Land: <u>Edd Waters</u> (Name)	Description & Color of Materials Sand, Clay, Red Clay, Shell, etc.	Thick- ness Feet	Depth Feet
(Address)	<u>blue clay</u>	<u>15</u>	<u>15</u>
(2) Location: _____ 1/4, _____ 1/4, Sec. <u>14 1/4 R 13 W</u>	<u>Sand</u>	<u>33</u>	<u>48</u>
_____ miles <u>South</u> of <u>Stallards</u> (distance) (direction) (Nearest Town)			
(3) Topography: <u>Flat</u> (Hilly) (Flat) (Level)			
(4) Purpose of Well: <u>Domestic</u> (Domestic Irrigation Municipal, Industrial, Other)			
Information upon completion of well:			
(1) Diameter <u>2</u> inches.			
(2) Total Depth <u>48</u> feet.			
(3) Water Level <u>33</u> feet below top of ground.			
(4) Cased to <u>48</u> , Size <u>2"</u>			
(5) Screen: Size <u>2"</u> , Length <u>5'</u>			
(6) Were any formations sealed against pollution? _____ yes, _____ no.			
If YES depth of formation _____			
Why _____			
Drillers Remarks: _____			
_____			
_____			
_____			

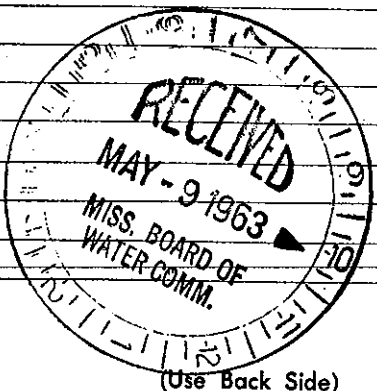

48  
54  
Well No.

Mail this copy to Board of Water Commissioners 429 Miss. St. Jackson, Miss.