

FORREST


D 66 ② WATER WELL DRILLERS LOG

9-15-60

Date: 9/15, 1960 Driller: Tims County: FORREST

(Name)

(1) Owner of Land: <u>PAUL RAYBURN</u> (Name)	Description & Color of Materials Sand, Clay, Red Clay, Shell, etc.	Thick- ness Feet	Depth Feet
(2) Location: <u>HATTIESBURG, MISS</u> <u>Drifted Sub Division as per</u> <u>plot on file in the Court House</u> <u>of Forrest Co., Miss.</u> miles (distance) direction (Nearest Town)	<u>0-12 Red Sandy Clay</u> <u>12-72 Red Sand</u> <u>72-94 White Sand + pebbles</u>		
(3) Topography: <u>Hilly</u> (Hilly) (Flag) (Level)			
(4) Purpose of Well: <u>HOME</u> (Domestic Irrigation Municipal, Industrial, Other)			
Information upon completion of well:			
(1) Diameter <u>2</u> inches.			
(2) Total Depth <u>94</u> feet.			
(3) Water Level <u>76</u> feet below top of ground.			
(4) Cased to <u>89</u> , Size <u>2"</u>			
(5) Screen: Size <u>2"</u> , Length <u>5ft</u>			
(6) Were any formations sealed against pollution? _____ yes, <input checked="" type="checkbox"/> no.			
If YES depth of formation _____			
Why _____			
Drillers Remarks: _____			

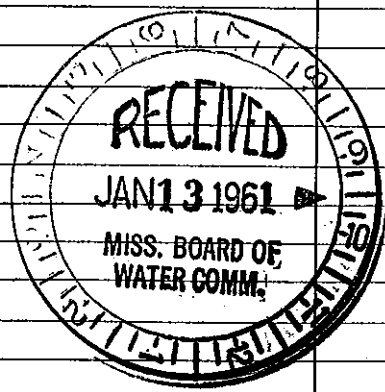

(Use Back Side)

Well No. 6

Mail this copy to Board of Water Commissioners 429 Miss. St. Jackson, Miss