

FORREST  
 D105  
 8/81  
 Log # 173

MISSISSIPPI  
 BOARD OF WATER COMMISSIONERS  
 416 North State Street  
 Jackson, Mississippi 39201

CODED

WATER WELL DRILLERS LOG

Aug. 1981 GRIVER DRILLING SERVICE FORREST  
 date well completed firm name county well located

LANDOWNER: MISSISSIPPI  
POWER CO., Hattiesburg  
MISS.  
 (mailing address)

description of formations encountered	from	to
Fill dirt	0	3
SANDY CLAY	3	30
CLAY	30	95
SAND	95	120
CLAY	120	125


WELL LOCATION: NW NE BLV  
 sec. 10 T. 4 N. R. 13 E  
 S W

(distance) miles (direction) of (nearest town)

WELL PURPOSE:  
 (home, irrigation, municipal, industrial)

WELL COMPLETION DATA:

- (1) diameter (inches) 6"
- (2) total depth (feet) 122 ft.
- (3) static water level (feet) 23 (below/above top of ground)
- (4) casing steel 88 ft.  
 (material) (depth)  
6" (size) If telescope see back.
- (5) screen 30 ft. 90  
 (length) (depth to top)  
4 (size) 1008-307 S.S. (material)
- (6) pump 5 (HP) 100 (yield gpm)  
Elect. (type power)
- (7) electric log yes (yes or no)  
MISS. Geol. Survey (organization running log)
- (8) how well bottom plugged BACK  
WASH VALVE

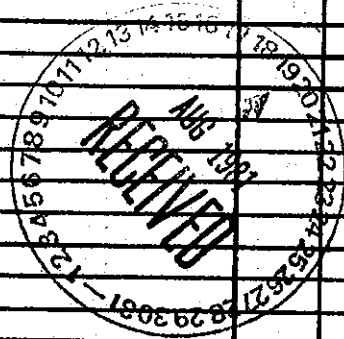

DRILLERS REMARKS: