


FORREST
 D104
 12-10-80
 Elog #167

CODED
 MISSISSIPPI
 BOARD OF WATER COMMISSIONERS
 416 North State Street
 Jackson, Mississippi 39201

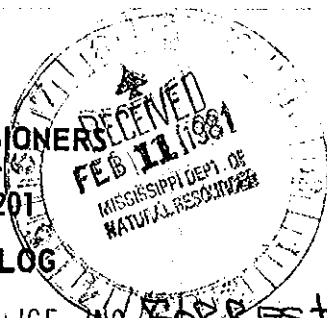

WATER WELL DRILLERS LOG

12-10-80 date well completed
 BRADEN PUMP AND WELL SERVICE firm name
 FORREST county well located

LANDOWNER:
 Miss. Tank Company
 4th Street
 Hattiesburg, MS
 (mailing address)

WELL LOCATION:
 sec. 6 T 5 N R 13 E
 4 N S W
 in miles of Hattiesburg
 (distance) (direction) (nearest town)

WELL PURPOSE: INDUSTRIAL
 (home, irrigation, municipal, industrial)

WELL COMPLETION DATA:
 (1) diameter (inches) 6"
 (2) total depth (feet) 700'
 (3) static water level (feet) 80 below top of ground.
 (4) casing PVC total, 6" (size) if telescope see back.
 (5) screen 40' 660 (length) (depth to top) 4" stainless steel (size) (material)
 (6) pump 20 300 (HP) (yield gpm) 230 (type power) @ 40*
 (7) electric log YES (yes or no)
 (organization running log)
 (8) hqw well bottom plugged 4" B.W. valve

description of formations encountered	from	to
White clay	0	120
Sand	120	150
Clay & Rock	150	300
Sand	300	430
Clay	430	580
Sand	580	700
160 pump setting		

DRILLERS REMARKS:
 No tail pipe